


T. 39 S., R. 14 W., W.M.

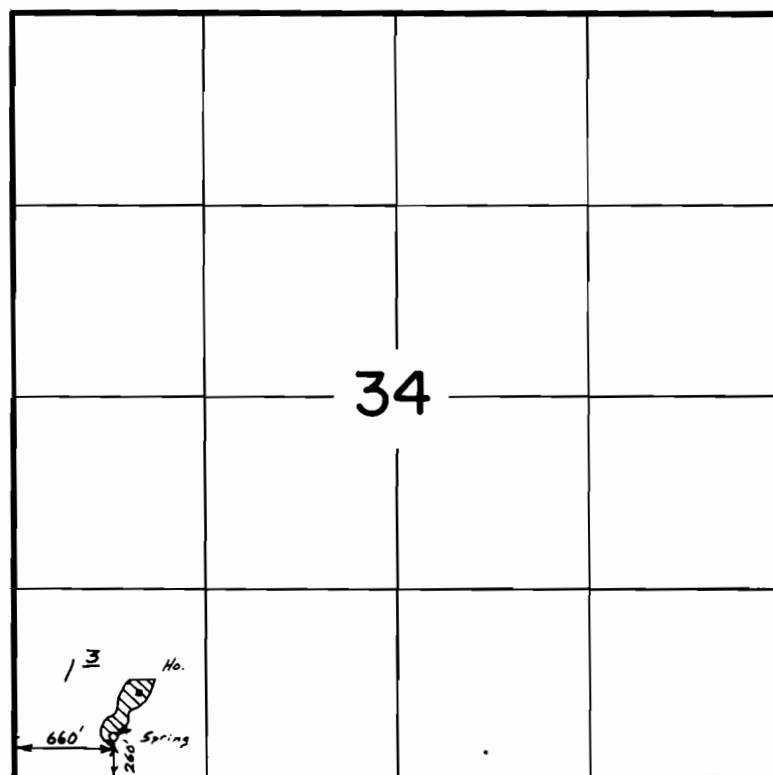

Scale 1"=1320'



FINAL PROOF SURVEY UNDER

Application No. 54820 Permit No. 41128
IN NAME OF

ROBERT E. BRANNAGAN

Surveyed Oct. 10, 1985, by J. M. SCHMORDE
Oct. 9, 1988, B.S. JAMES