


# T.3S., R.45E., W.M.

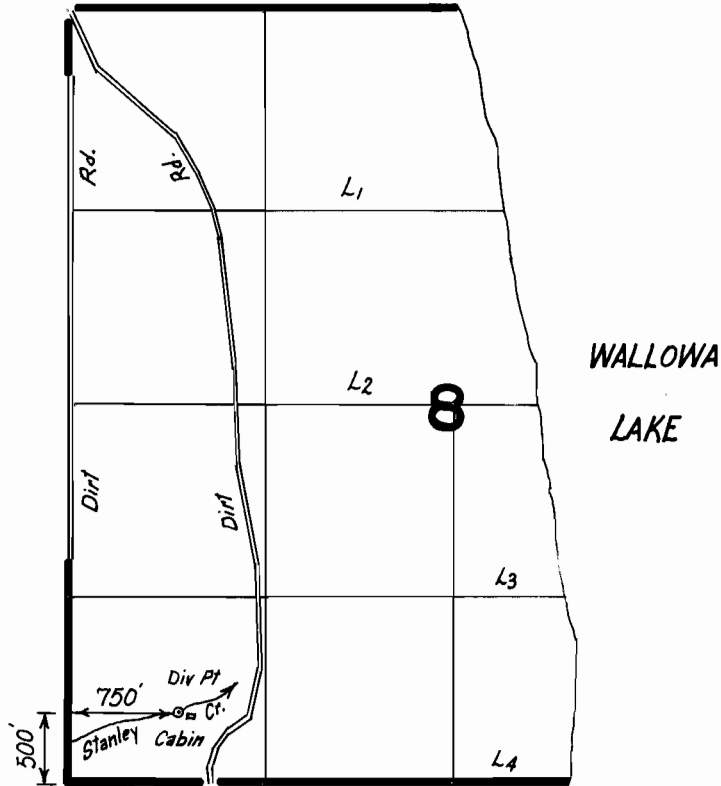

## FINAL PROOF SURVEY

UNDER

Scale: 1" = 1320'

Application No. **54987**. Permit No. **41266**.....  
 IN NAME OF

**JOHN C. & MARGARET M. COOK**.....

Surveyed **8-15**..... 1988., by **Vern Church**.....