


T. 5 & 6N., R. 43E., W.M.

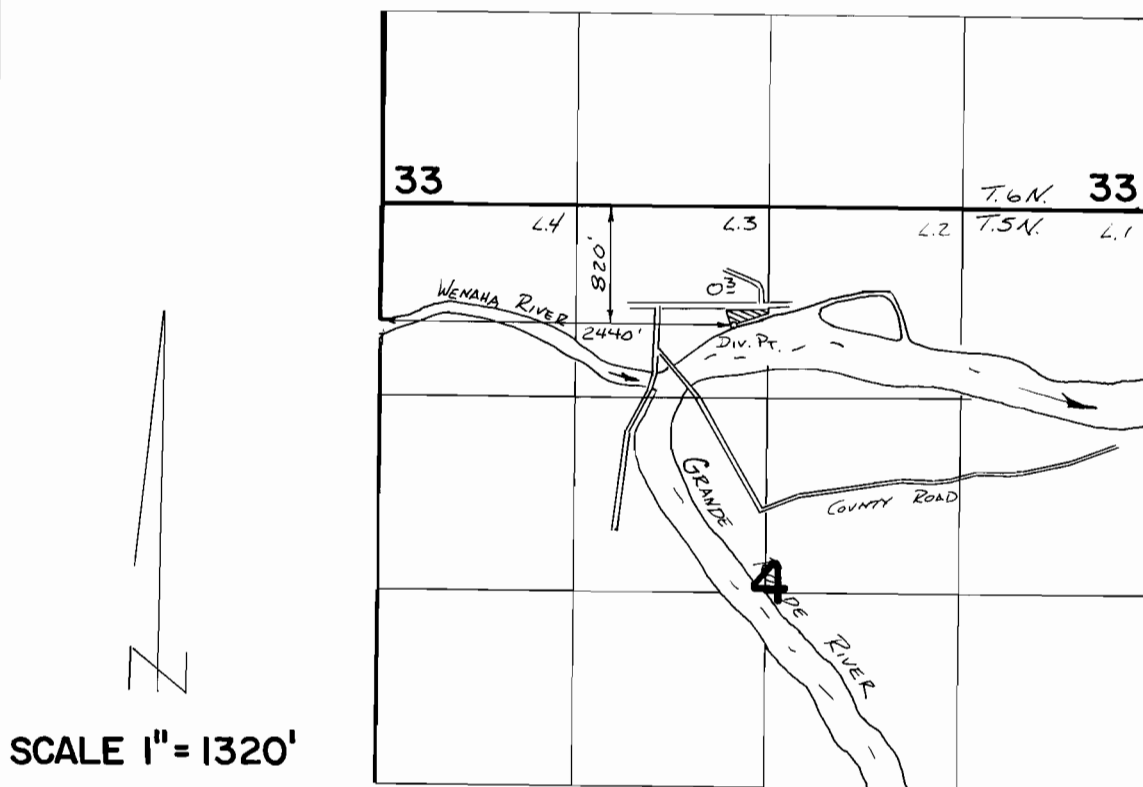

FINAL PROOF SURVEY
UNDER

Application No. **55005** Permit No. **41317**.....
IN NAME OF

.....**RAY W. MILLIGAN**.....

Surveyed **8-16**..... **1988**, by **V.L. Church**.....