


T. 30 S., R. 2 W., W. M.

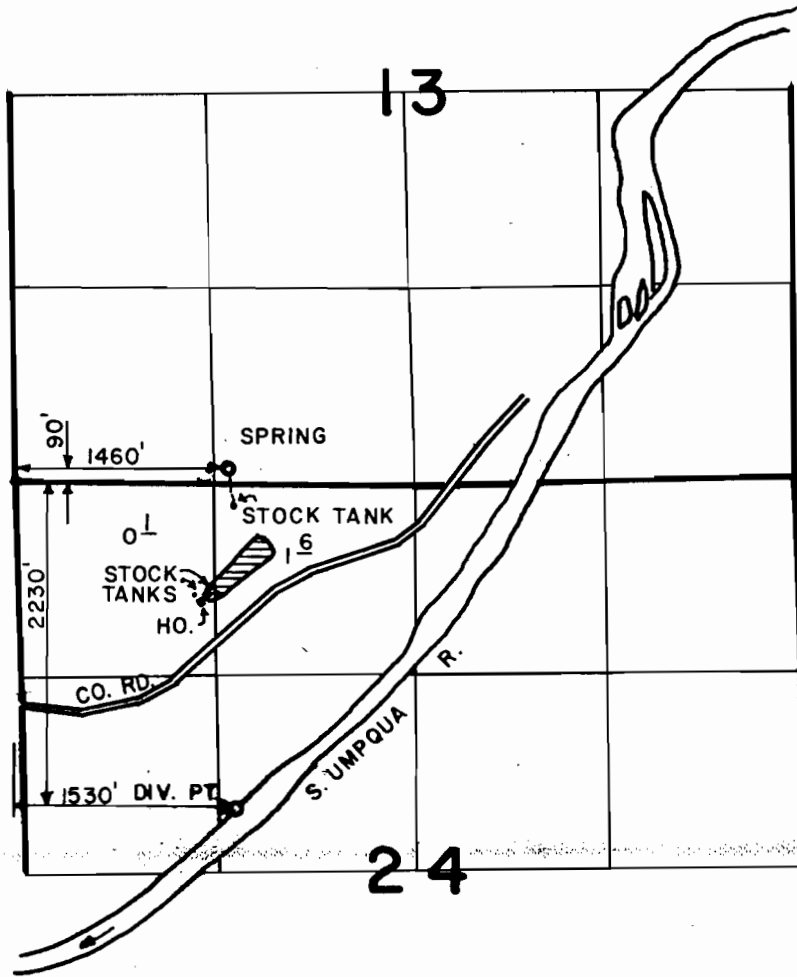

SCALE: 4" = 1 MILE

FINAL PROOF SURVEY
UNDER

Application No. 57797 55349 Permit No. 43747 41795
IN NAME OF

JOHN G. GIBSON

Surveyed AUG. 20. 1985. by J. M. SCHMORDE