


T. 40S., R. 14 W., W.M.

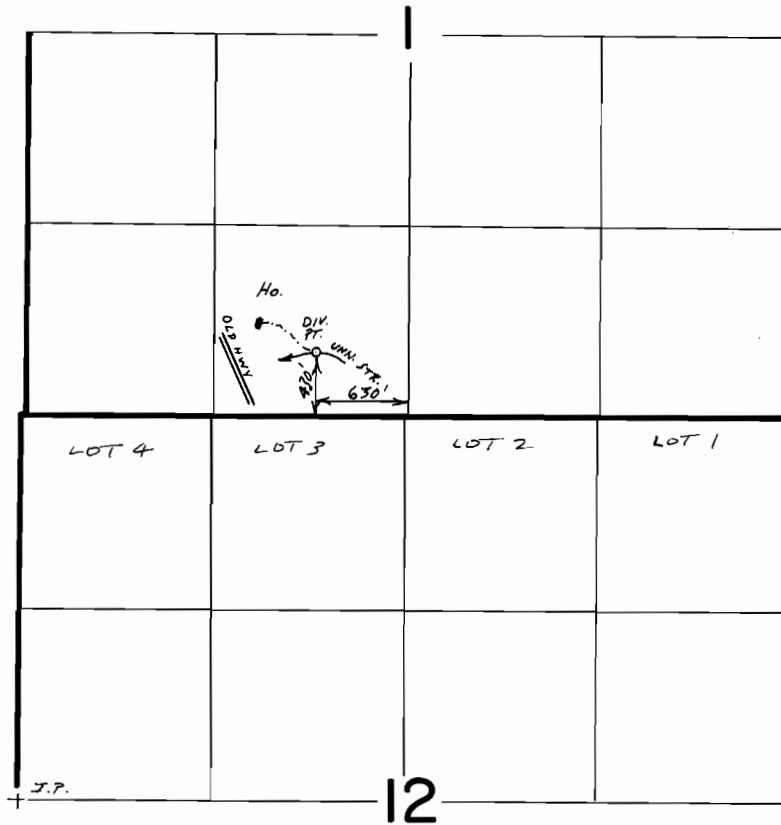

Scale 1" = 1320'

N

FINAL PROOF SURVEY
UNDER

Application No. 55463. Permit No. 41827.....
IN NAME OF

ERNEST A. DENNIS.....

Surveyed Sept. 3, 1987, by J. KAUPPILA.....