




T. 40 S., R. 14 W., W.M.

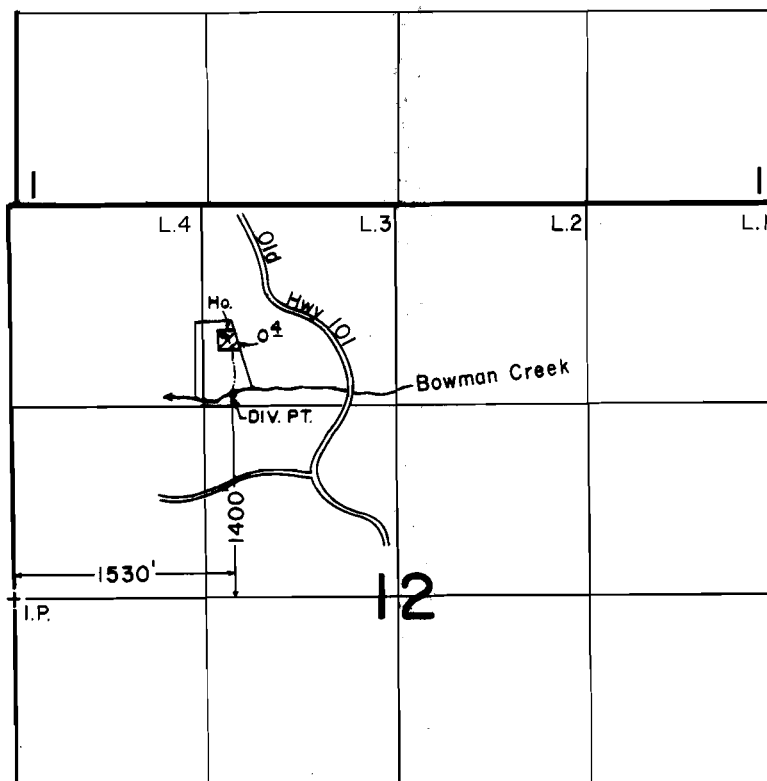

SCALE: 1" = 1320'

FINAL PROOF SURVEY
UNDER

Application No. 56917... Permit No. 42893....
IN NAME OF

LARRY C. THOMAS

Surveyed AUG. 14... 1989, by B. S. JAMES