


T. 30 S., R. 2 W., W. M.

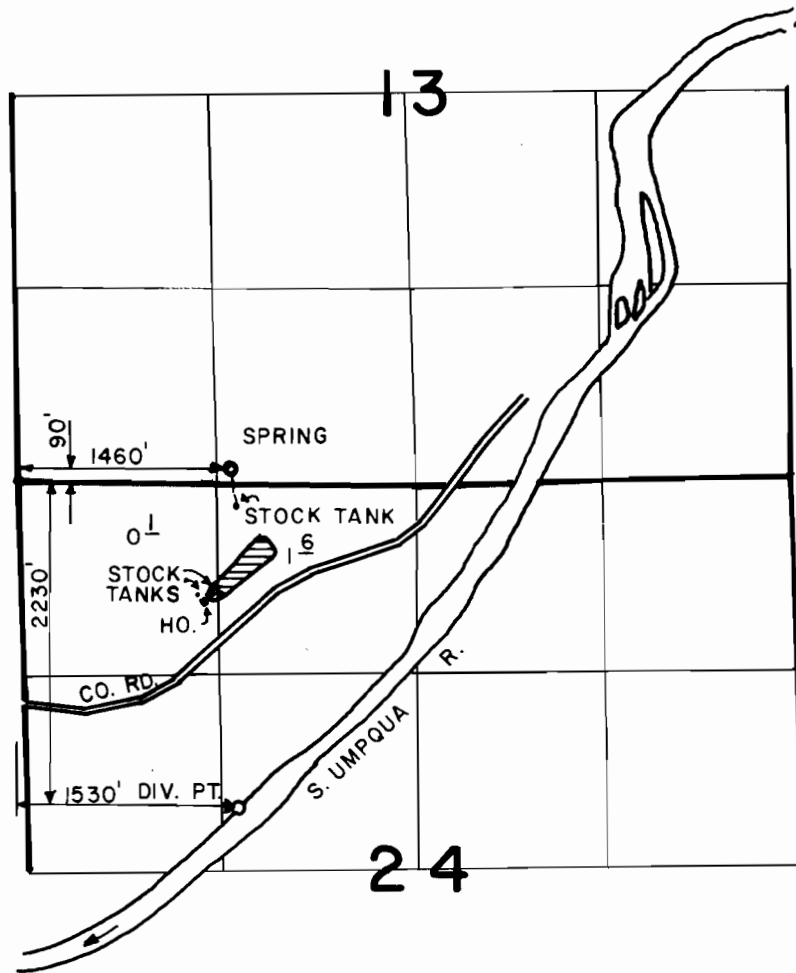

SCALE: 4" = 1 MILE

FINAL PROOF SURVEY
UNDER

Application No. 57797 Permit No. 43747
55349 41795
IN NAME OF

JOHN G. GIBSON

Surveyed AUG. 20, 1985, by J. M. SCHMORDE