


T.18S. R.2&3W. W.M.

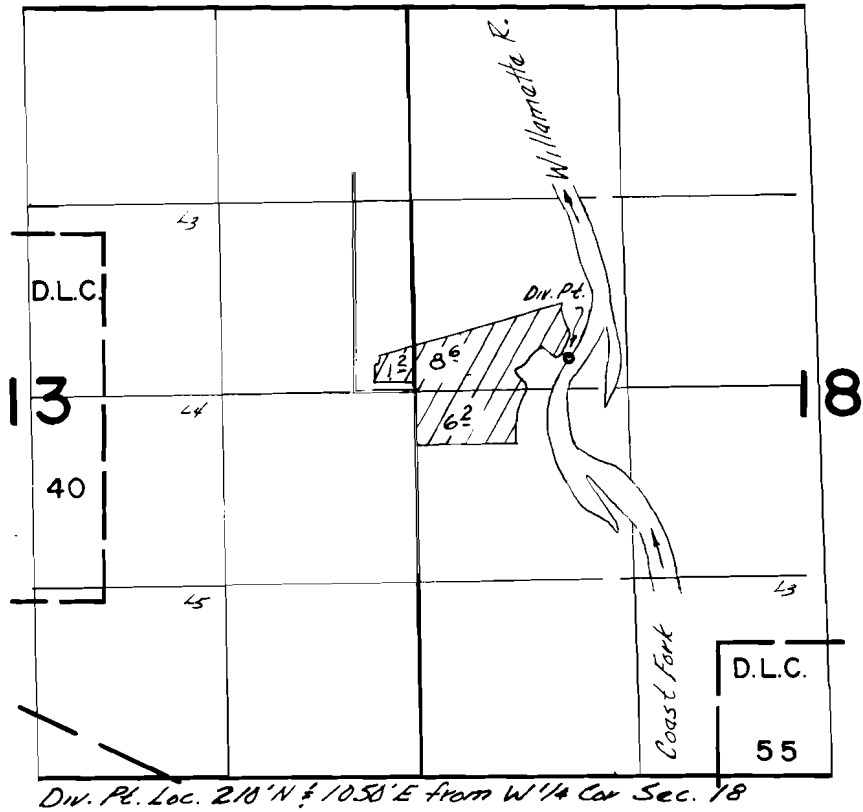


FINAL PROOF SURVEY UNDER

Application No. ~~58388~~.. Permit No. .44.000....
IN NAME OF

.....Steven M. Houston.....

Surveyed Oct....9.... 1979., by C.R.RODRIGUEZ.