


T. 7 S., R. 3 W., W. M.

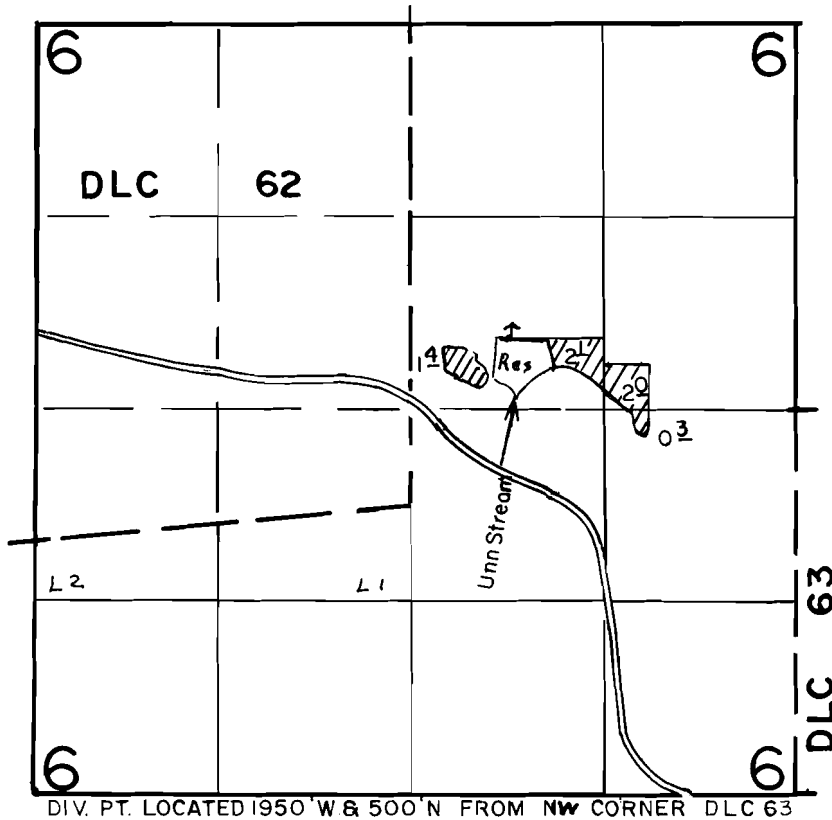

DIV. PT. LOCATED 1950' W & 500' N FROM NW CORNER DLC 63

SCALE: 1" = 1320'

FINAL PROOF SURVEY
UNDER

R-58936 R-7979

Application No. 58937 Permit No. 44600.....

IN NAME OF

..... **WILLIS A. BYERS, JR.**

Surveyed OCT. 3, 1986., by B.W. BISHOP.....