


RECEIVED

JUN 23 1981

WATER RESOURCES DEPT
SALEM, OREGON

T.10S. R.12 & 13E W.M.

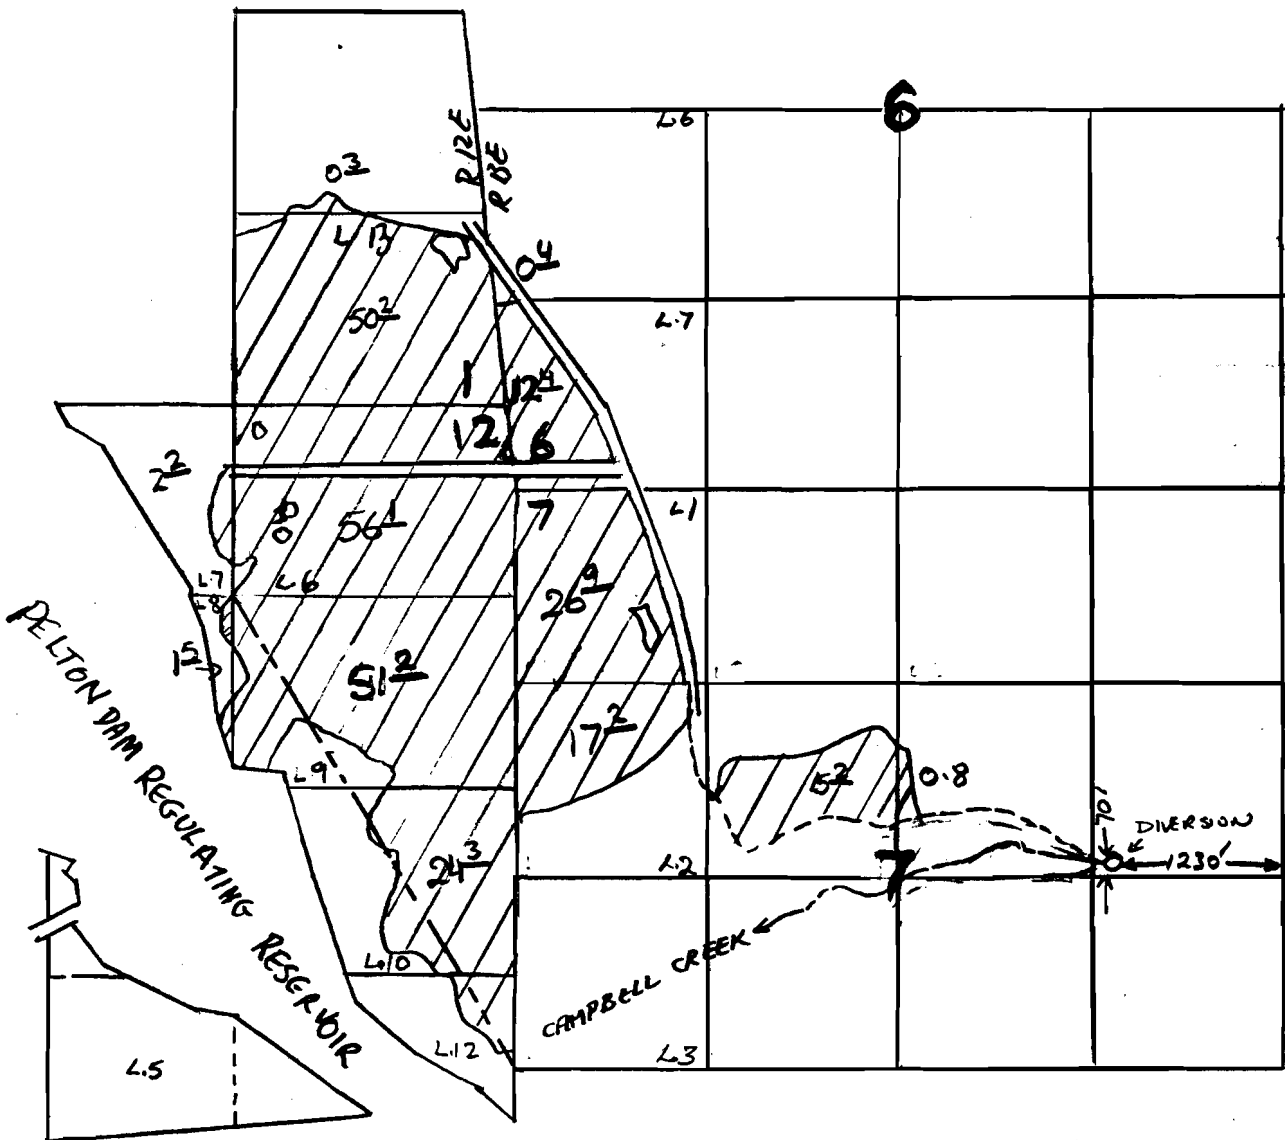

Application No. 60342

Permit No. 45835 C64916

THE CONFEDERATED TRIBES OF WARM SPRINGS INDIAN RESERVATION
OREGON