


T4S, R1&2E, WM

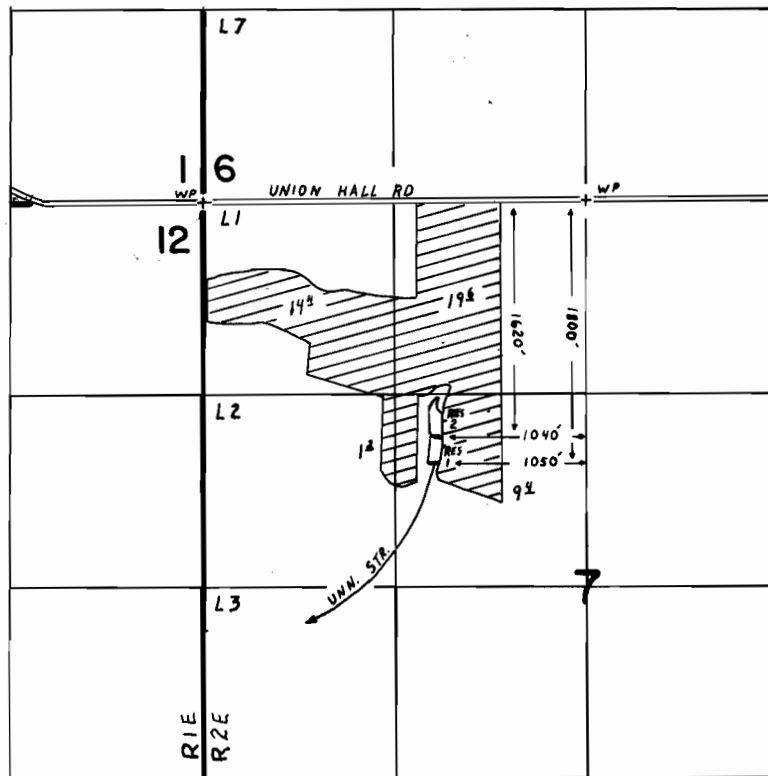

FINAL PROOF SURVEY UNDER

R-60922 R-8340
Application No. 60923 Permit No. 46396
IN NAME OF

FLOYD C. MARKS

Surveyed JULY 17, 1987, by T.M. WARREN