




T. 3 S., R. 1 E., W.M.

SECTION 12

M.M. McCARVER
DLC 41

NE 1/4 SW 1/4

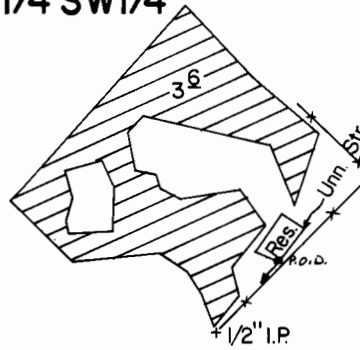

CO 1/4 cor.

DIV. PT. LOC.: 1130'S. & 190'W. FROM CENTER SECTION 12

SCALE: 1" = 400'

FINAL PROOF SURVEY
UNDER

R-61772

R-8274

Application No. 61233... Permit No. 45783.....

IN NAME OF

.....LESLIE ARNOLD SMELSER.....

Surveyed AUG. 26, 1986, by T. WARREN.....