


T. 6 S., R. 2 E., W. M.

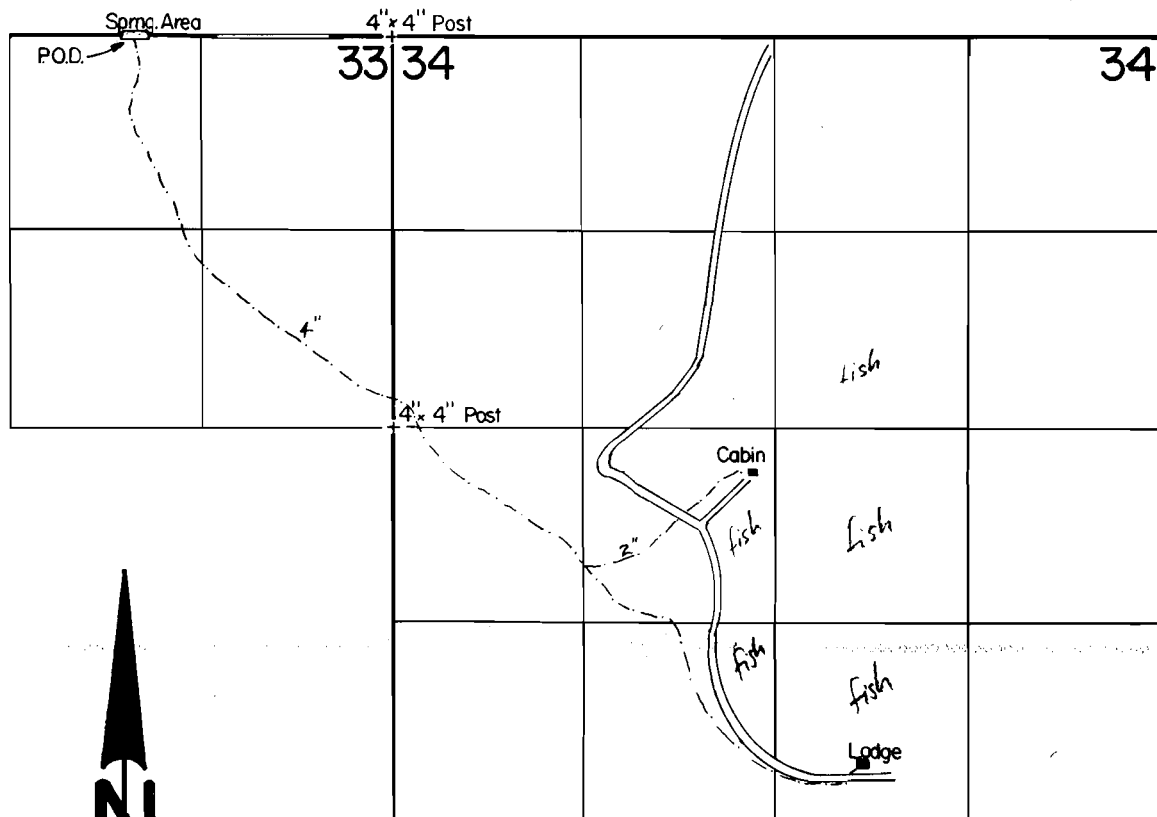

P.O.D. Loc. : 1750' W. from NW Cor. Sec. 34.

Note: Pipeline location is approximate.

Scale: 1" = 1320'

FINAL PROOF SURVEY
UNDER

Application No. 61286..... Permit No. 45833.....
IN NAME OF

WILLARD G. DEARDORFF

Surveyed JUNE 11, 1986, by J. Warren.....

41005-278-187 R
PTS-1986-A
1/15/87 TMW