


T. 26 S., R. 4 W., W.M.

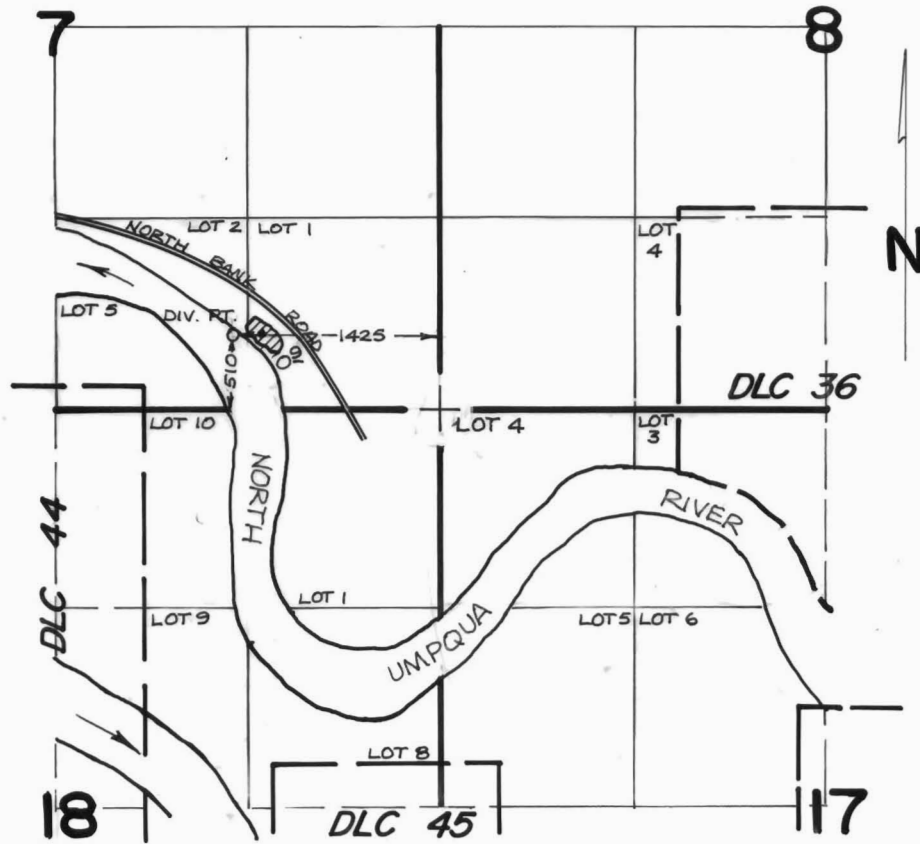

SCALE : 4" = 1 MILE

FINAL PROOF SURVEY UNDER

Application No. ...61297. Permit No.45611.....
IN NAME OF

.....MAX W. LOCKWOOD.....

Surveyed .SEPT. 10, 19.86, by .J.M. SCHMORDE.