



T. 26 S., R. 6 W., W.M.

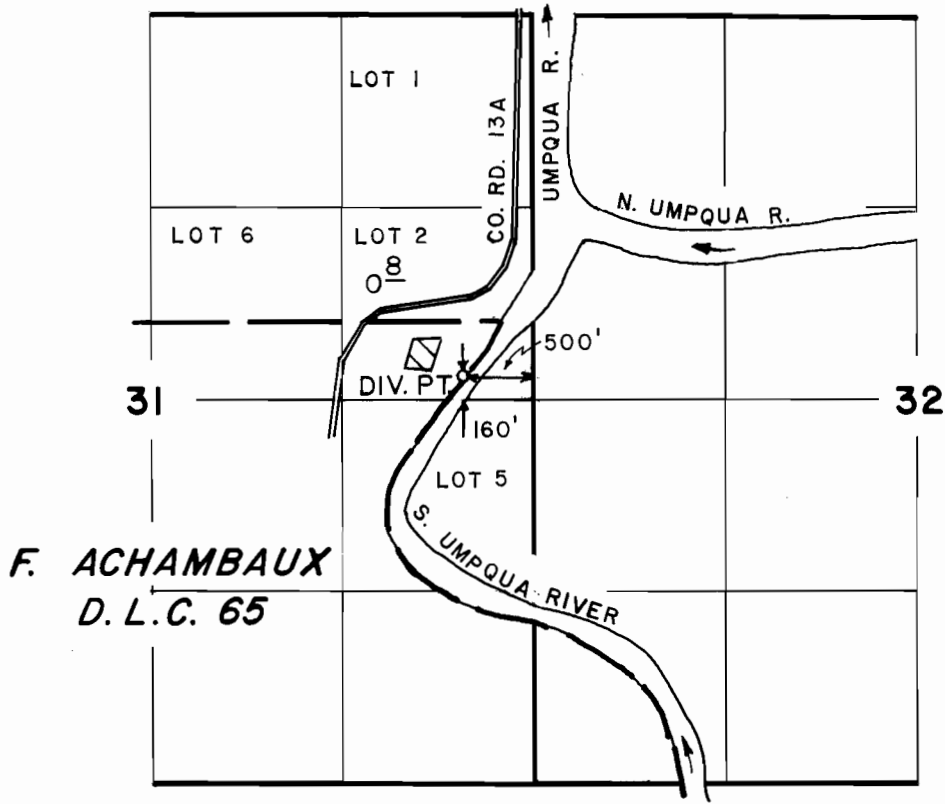

F. ACHAMBAUX
D.L.C. 65

SCALE: 4" = 1 MILE

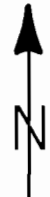

FINAL PROOF SURVEY UNDER

Application No. 61551 Permit No. 45810
IN NAME OF

MARTIN A. & LINDA K. RIGUTTO

Surveyed FEB. 14, 1985, by L. E. CASHION