


T.21S., R.5W., W.M.

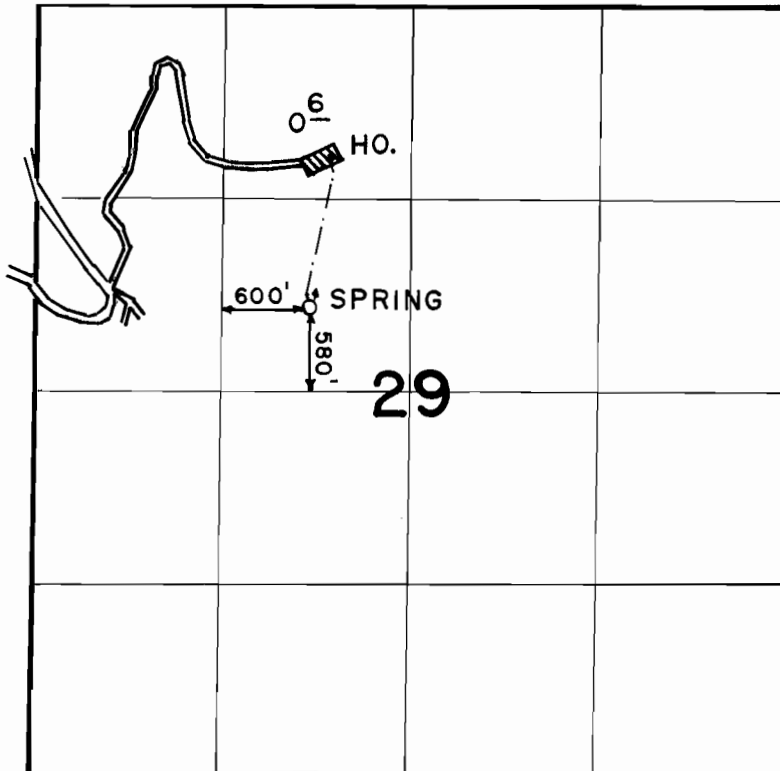

SCALE: 4" = 1 MILE

FINAL PROOF SURVEY
UNDER

Application No. 61565 Permit No. 45771
IN NAME OF

JOHN M. & HELEN R. RENTZ

Surveyed OCT. 8 1987, by J. M. SCHMORDE