


T. 29S., R. 4W., W.M. SECTION 18

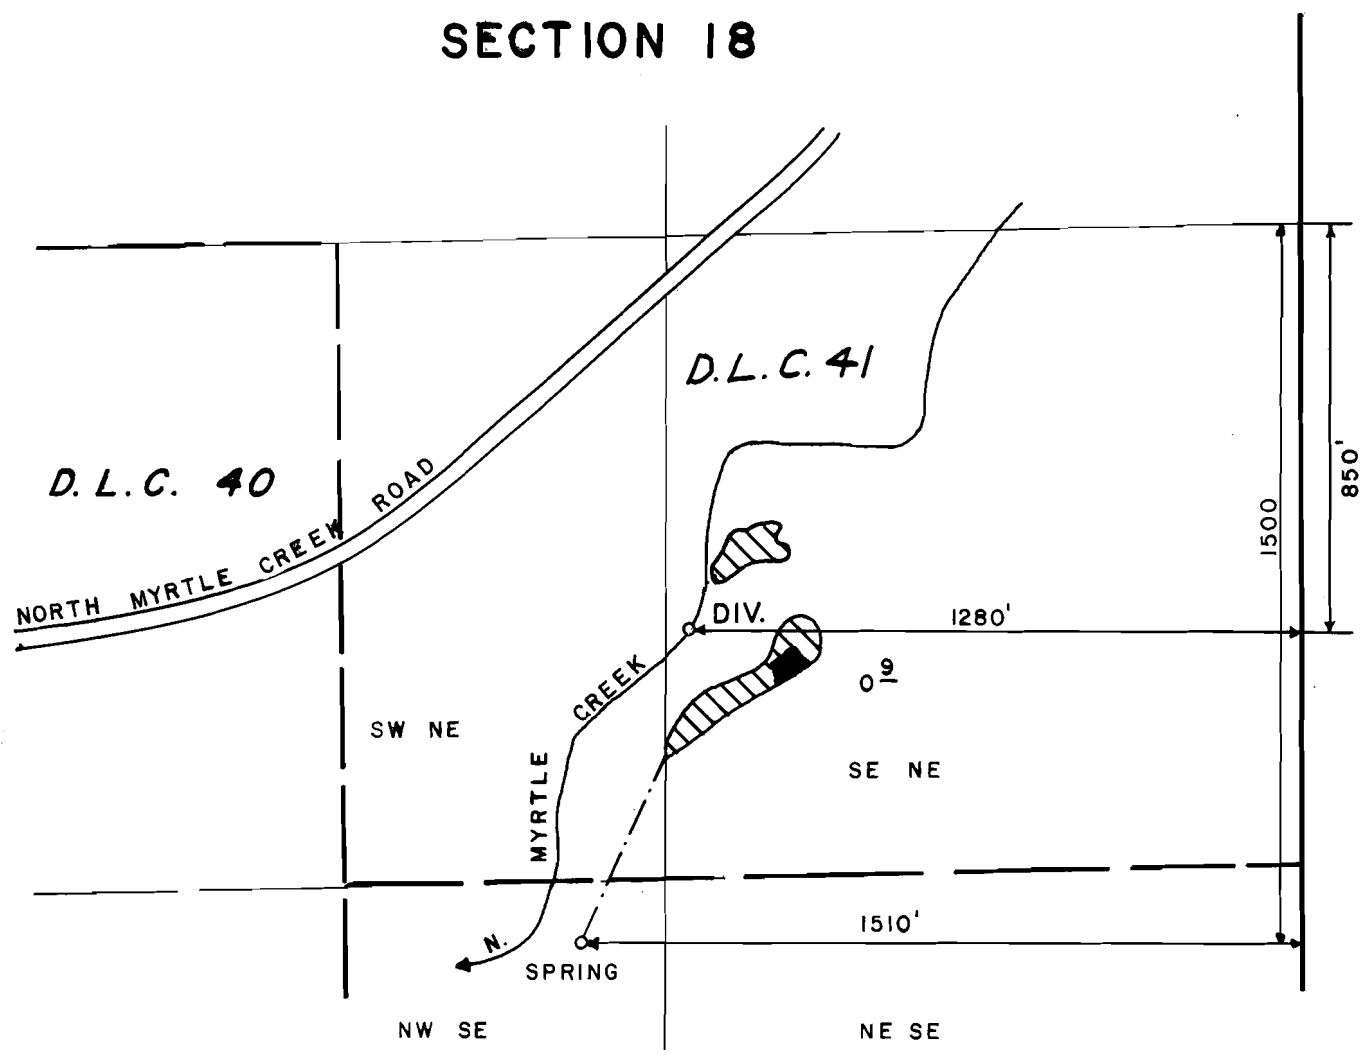

SCALE: 1" = 400'

FINAL PROOF SURVEY UNDER

Application No. 61586 Permit No. 45811
IN NAME OF

DONALD A. & MARY NIEMINEN

Surveyed MAY 14, 1986, by J. M. SCHMORDE