


T. 25 S., R 4 W., W. M.

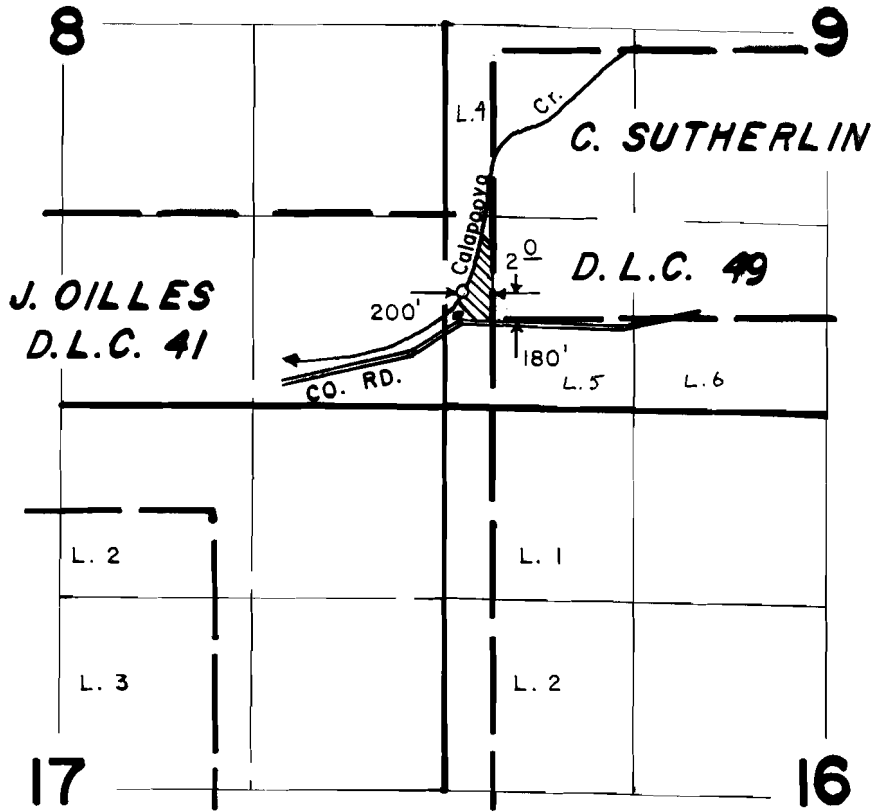

FINAL PROOF SURVEY
UNDER

Application No. 61652 Permit No. 45812
IN NAME OF

Louise Furukawa and John E. Pierce

Surveyed JUNE 11 1987, by J. M. SCHMORDE