


T.24S., R.5W., W.M.

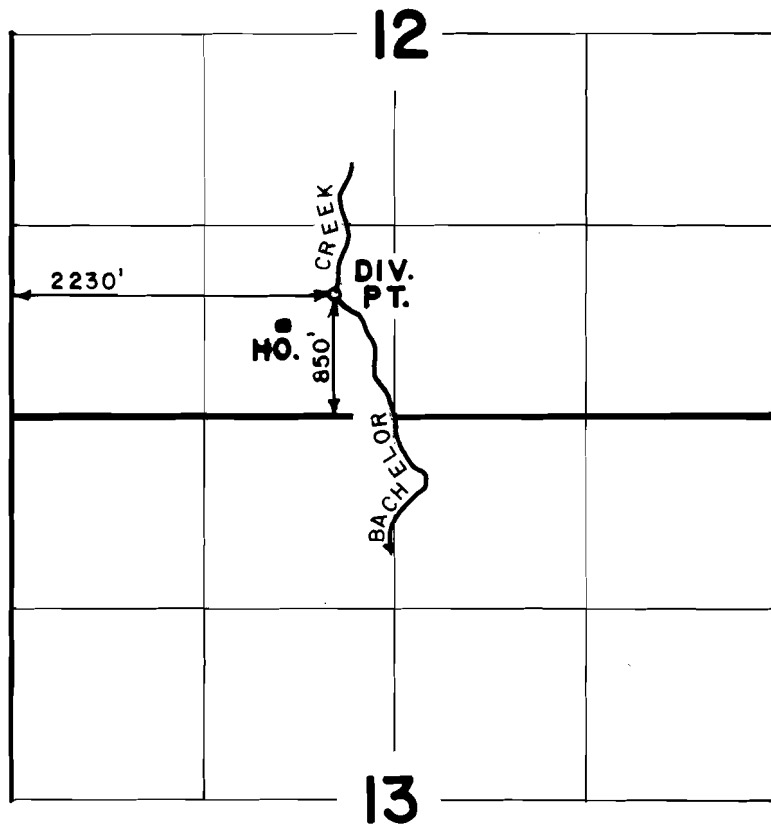

SCALE: 4" = 1 Mile

FINAL PROOF SURVEY
UNDER

Application No. **61687** Permit No. **45813**
IN NAME OF

SUSAN RODEN

Surveyed **OCT. 16** 19**86**, by **J.M. SCHMORDE**