
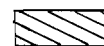


T. 4 S., R. 2 E., W. M.

Sec. 23

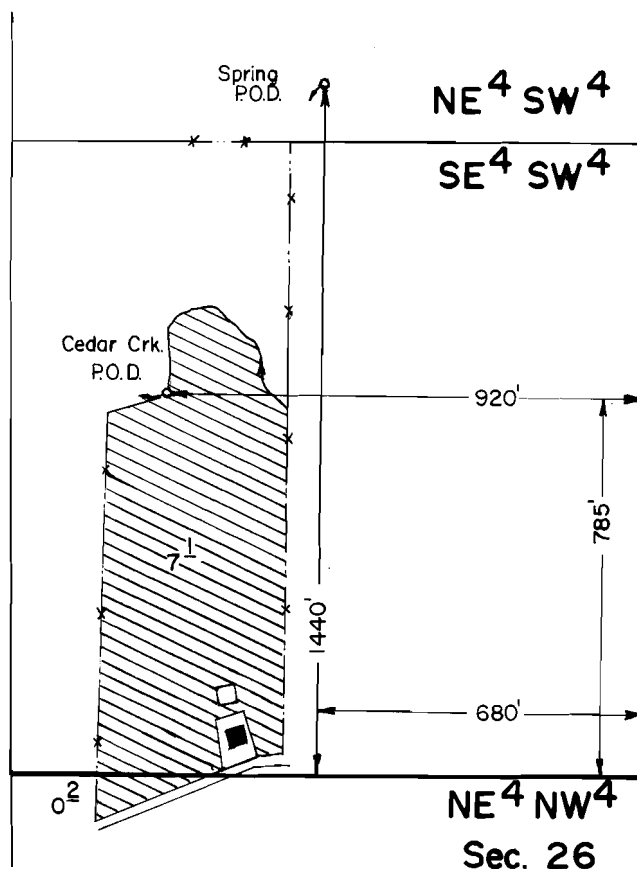

Cedar Crk. Irrig

Scale: 1" = 400'

FINAL PROOF SURVEY

UNDER



Spring Dom.

Application No. 61725... Permit No. 46237...

IN NAME OF

ROBERT & SHARON YANKEE

Surveyed JULY 8, 1986, by T. Warren

PTS-1986-A
1/29/87 TMW