


T. 4 S., R. 1 E., W. M.

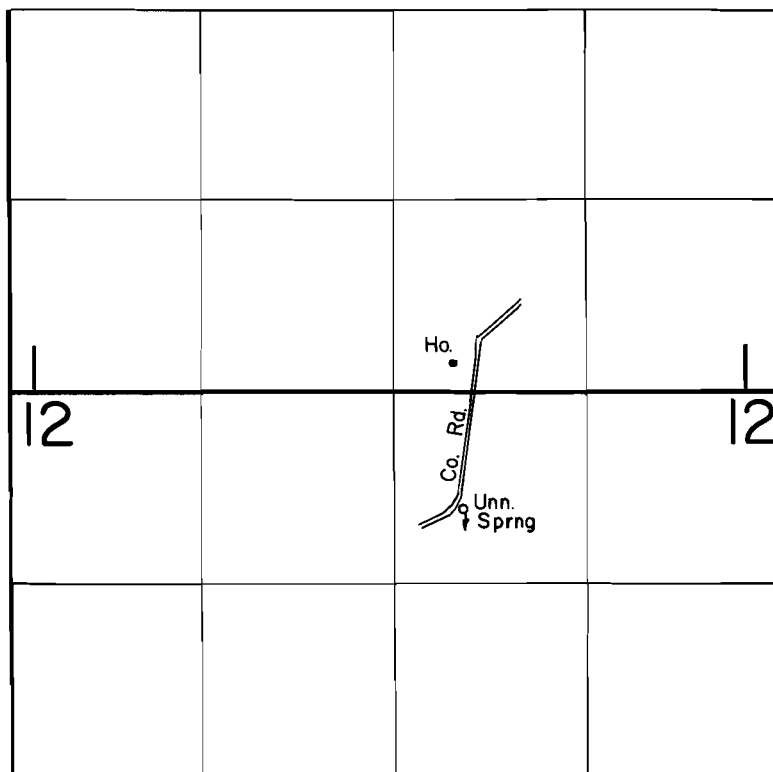

Spring Loc.: 810' S. & 480' E. from N. 1/4 Cor. Sec. 12.

Scale : 1" = 1320'

FINAL PROOF SURVEY UNDER

Application No. 61865 Permit No. 46249
IN NAME OF

FLORENCE M. SEXTON

Surveyed AUG. 11 1989, by R. KLASSEN