
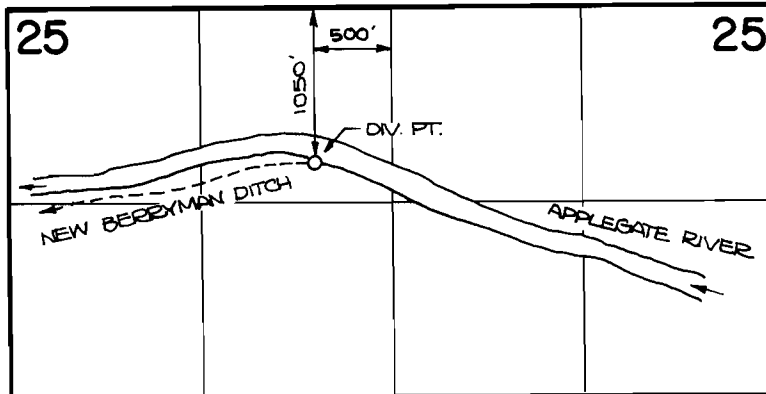


# T.38S. R.4W. W.M.

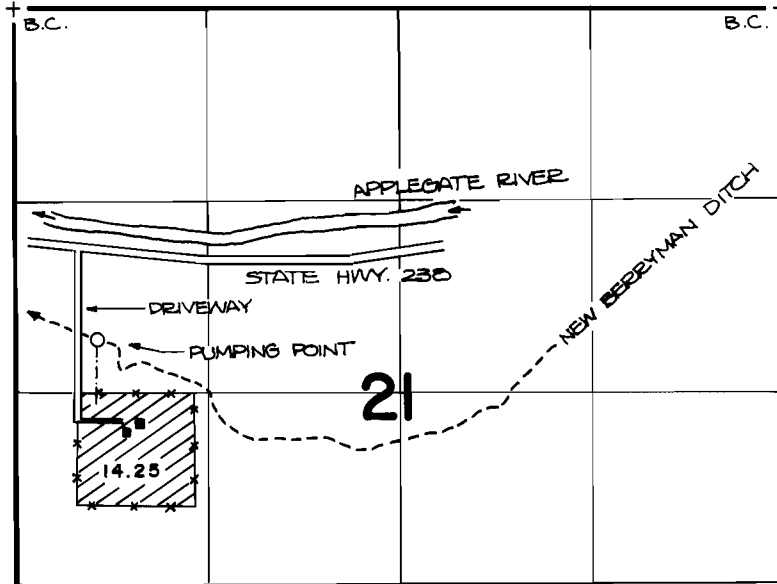

## FINAL PROOF SURVEY UNDER

Application No. **62027** Permit No. **46586**..  
IN NAME OF

.....**THOMAS BROGAN**.....

Surveyed **JULY 28**, 19**83**, by **B. JAMES**.....