Ammended Map.
appl.# 62128

RECEIVED
WATER ... DEPT
SAL... ...ON

T.38S., R.3W., W.M.

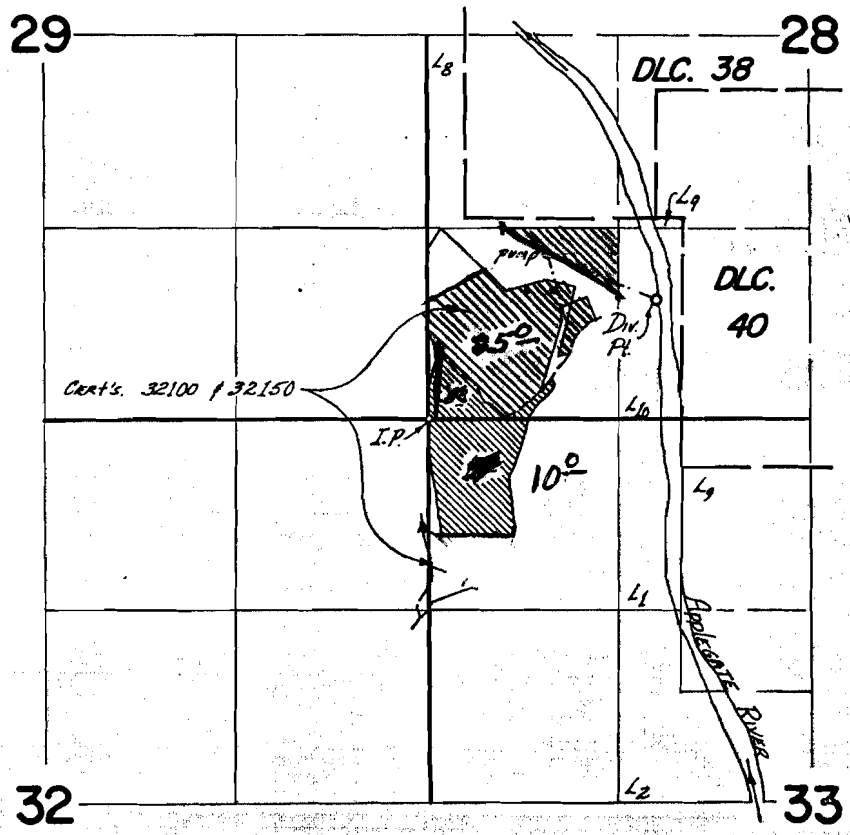

Div. Pt. loc: 820' N. & 1580' E. from SW cor. Sec. 28

Application No. 62128

Permit No. 46355

FINAL PROOF SURVEY

UNDER

~~Application No. 43265 Permit No. 32339~~

IN NAME OF

MARION DUNLAP

Surveyed Oct. 18 1973, by D. Norby

BAX-4AA-83