


T. 1 S., R. 3 W., W. M.

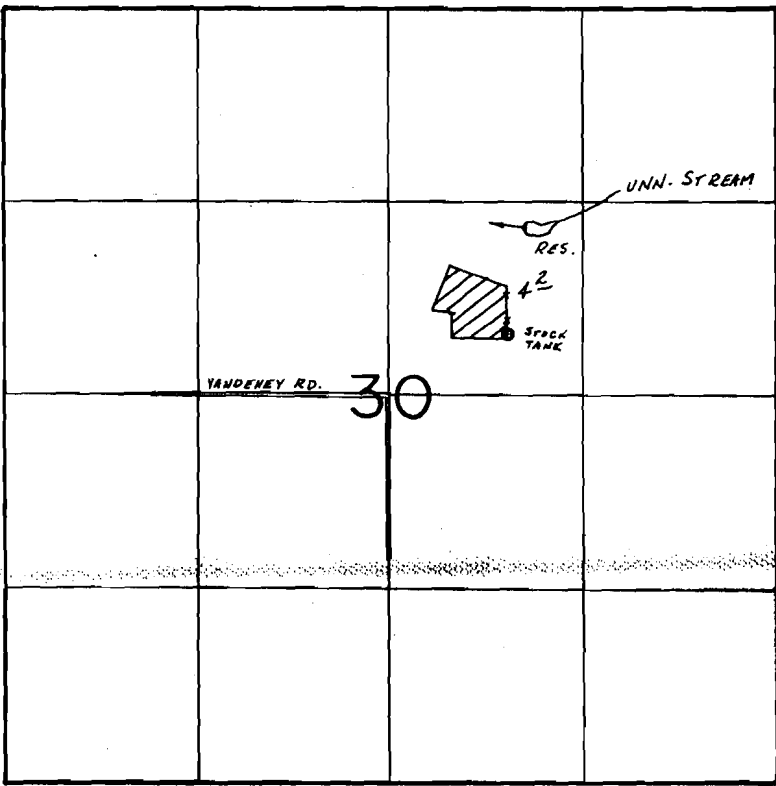

Div. Pt. Loc.: 1500'S. & 940'E. FROM N 1/4 COR. SEC. 30.

SCALE: 1" = 1320'

FINAL PROOF SURVEY
UNDER

R-62150 R-8312
Application No. 62151... Permit No. 46106.....
IN NAME OF

.....JANIS M. BRABHAM.....

Surveyed Aug. 11... 1986, by R.W. BISHOP.....

1/2/87
625

PTS 192LR