
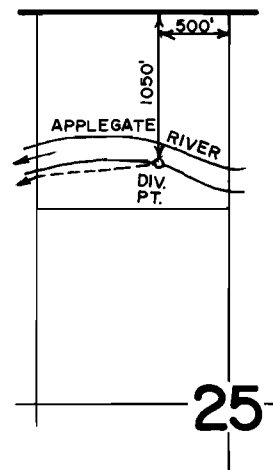


T. 38 S., R. 4 W., W.M.

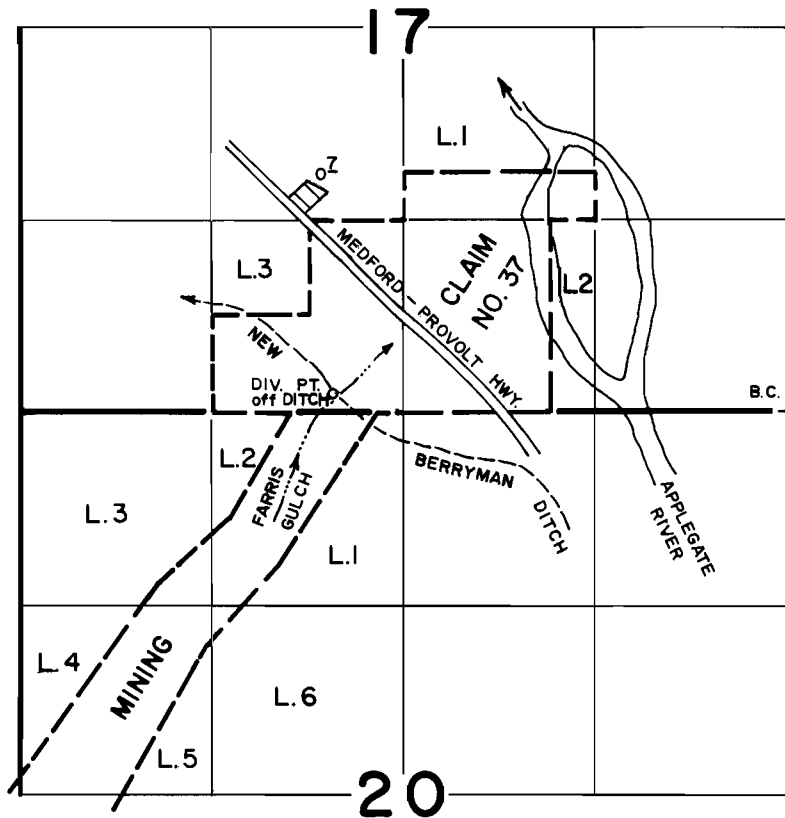

FINAL PROOF SURVEY
UNDER

Application No. 62263 Permit No. 46086.....
IN NAME OF

PETER CURTIS

Surveyed JULY 28 19.83, by B. S. JAMES.....

SCALE: 4" = 1 MILE