


T. 3 S., R. 3 W. W.M.

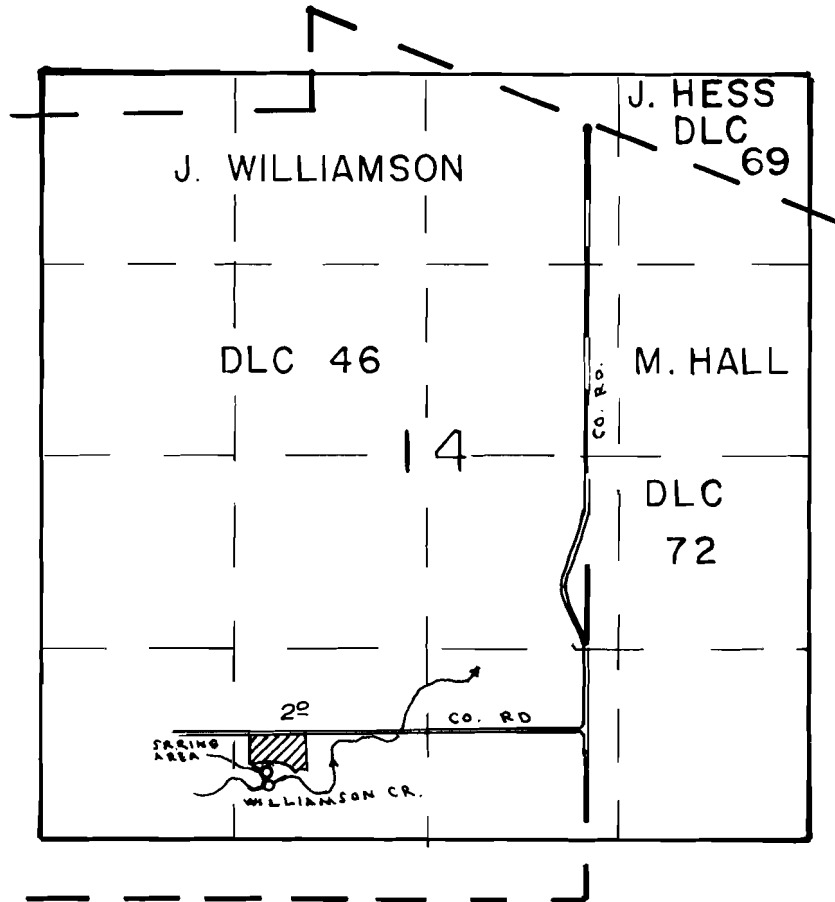

DIV. PT. LOC.: CREEK - 400' N. & 1560 E. OF SW COR. SEC. 14
SPRING - 470' N. & 1570 E. OF SW COR. SEC. 14

FINAL PROOF SURVEY
UNDER

o Application No. 62361 Permit No. 46325
IN NAME OF

MALCOLM TROWBRIDGE

Surveyed JUL 2 1984, by P. PAGTER