


T. 37 S., R. 6 W., W. M.

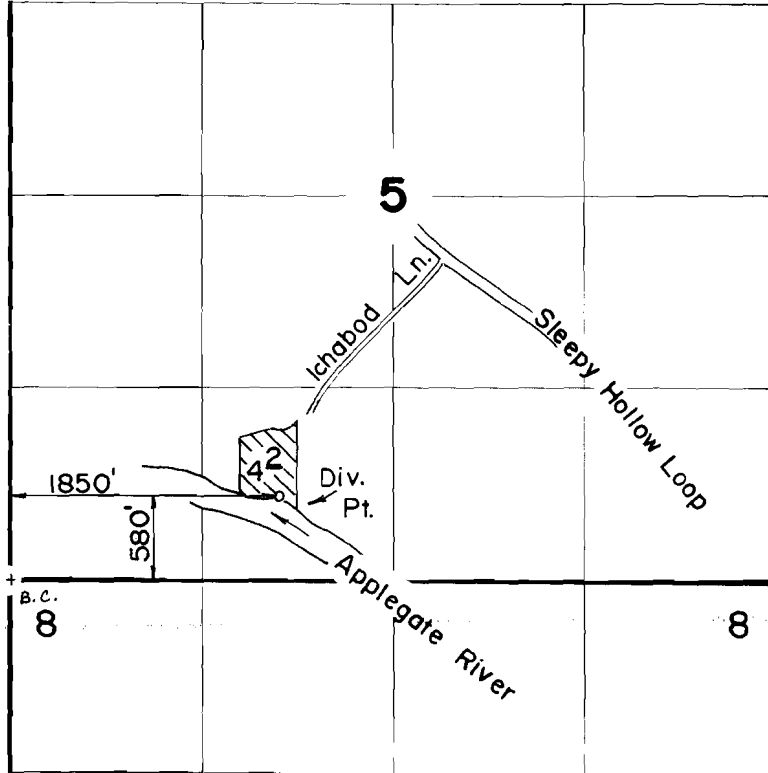

Scale: 1" = 1320'

FINAL PROOF SURVEY
UNDER

Application No. ⁵625~~3~~ Permit No. 46947...
IN NAME OF

ROBERT J. MILLER

Surveyed AUG. 14, 1986, by B. S. JAMES