


T. 29S., R. 4W., W.M.
SECTIONS 23 & 24

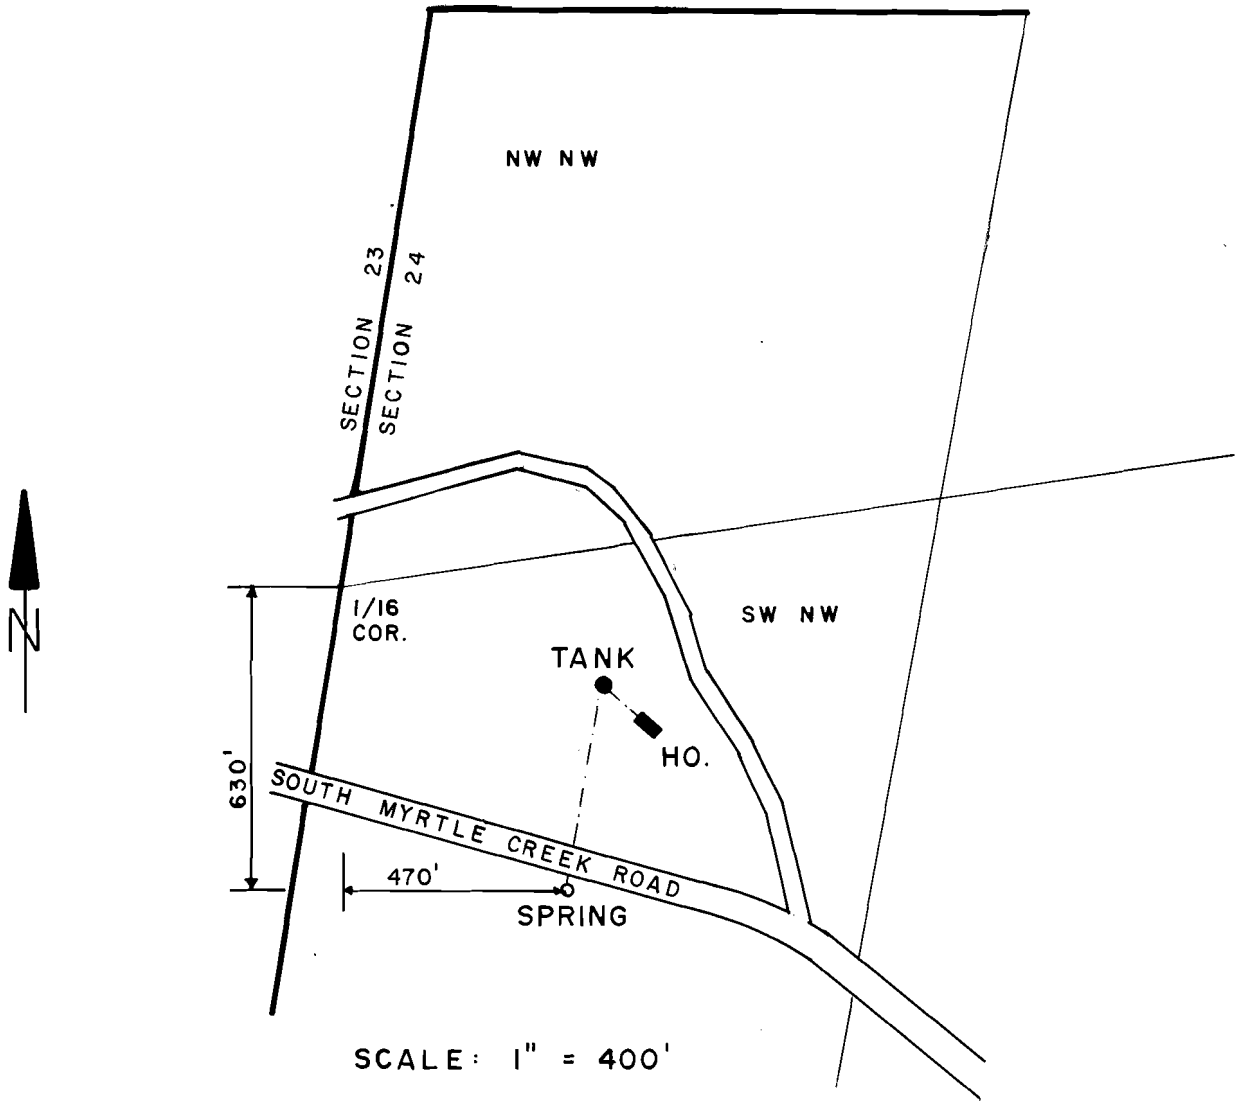

FINAL PROOF SURVEY
UNDER

Application No. 62833 Permit No. 46145
IN NAME OF

WILLIAM LEROY JONES

Surveyed MAY 8, 1986, by J. M. SCHMORDE