


T. 29 S., R. 6 W., W.M.

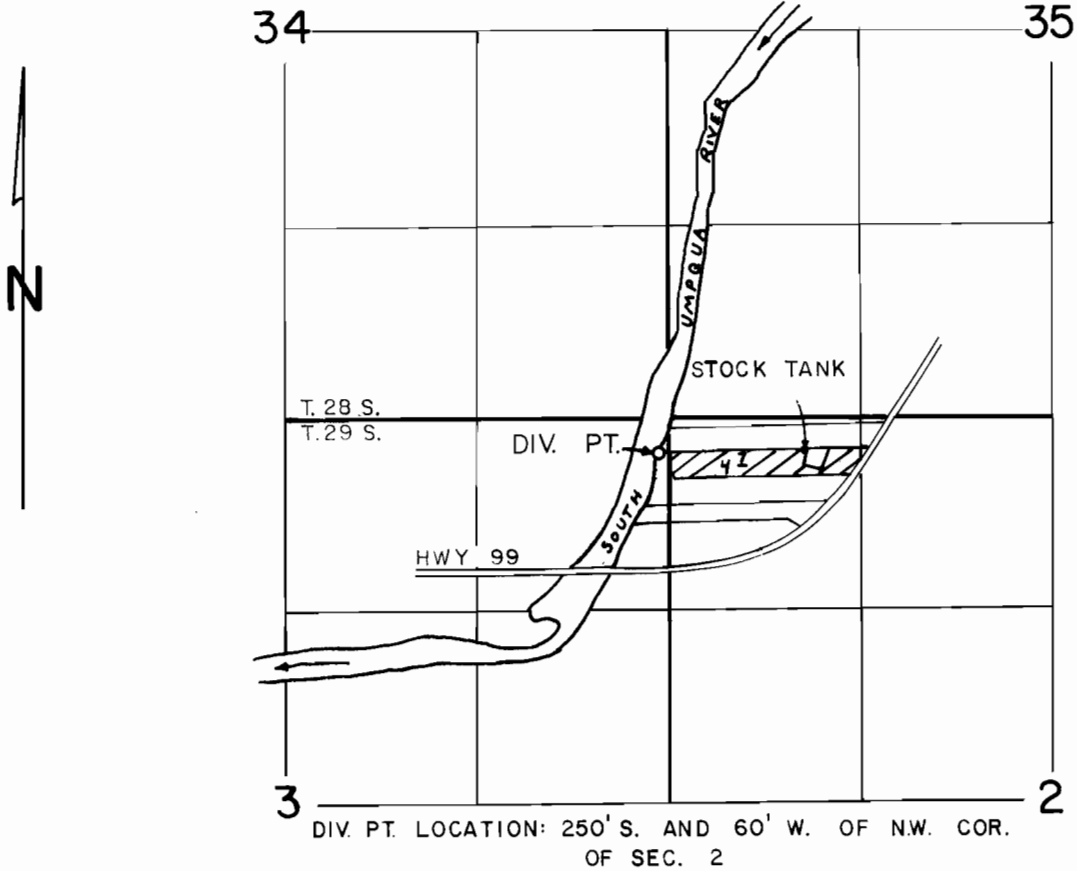

SCALE: 4" = 1 mile

FINAL PROOF SURVEY
UNDER

Application No. 63010 Permit No. 46636.....
IN NAME OF

VERNON L. and RUBY McDOWELL

Surveyed DEC. 14, 19.83, by L. E. Cashion