


T.37S., R.14&15W., W.M

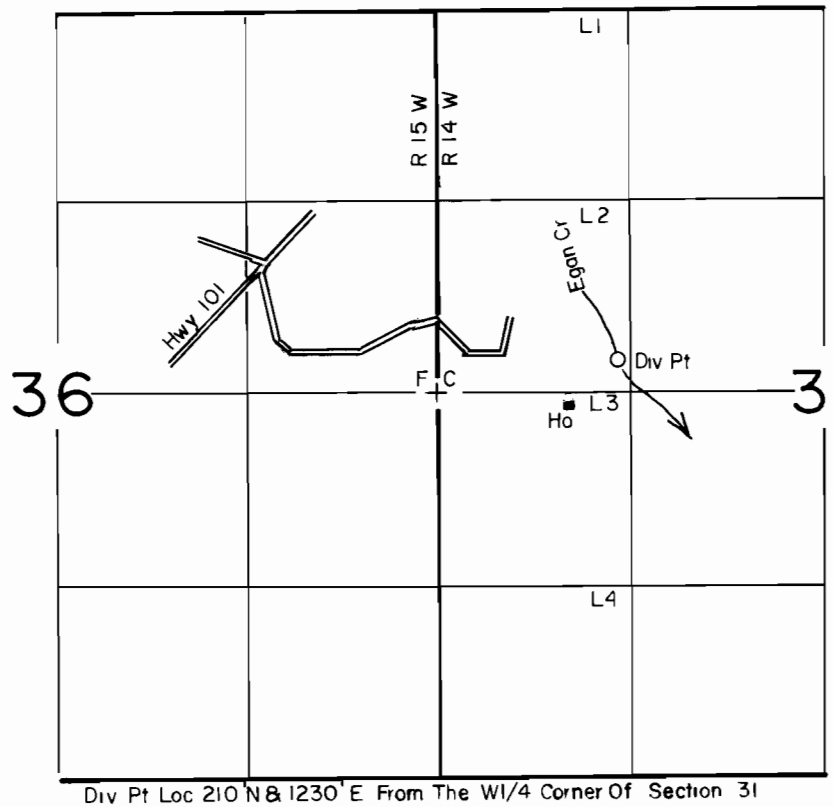

SCALE: 1"=1320'

FINAL PROOF SURVEY
UNDER

Application No. 63445.. Permit No. 46782.....
IN NAME OF

JAMES H & NINA D BOSCHMA

Surveyed JULY 28.. 1989., by B.S. JAMES.....