
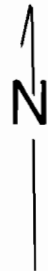


T. 35S., R. 14W., W.M.

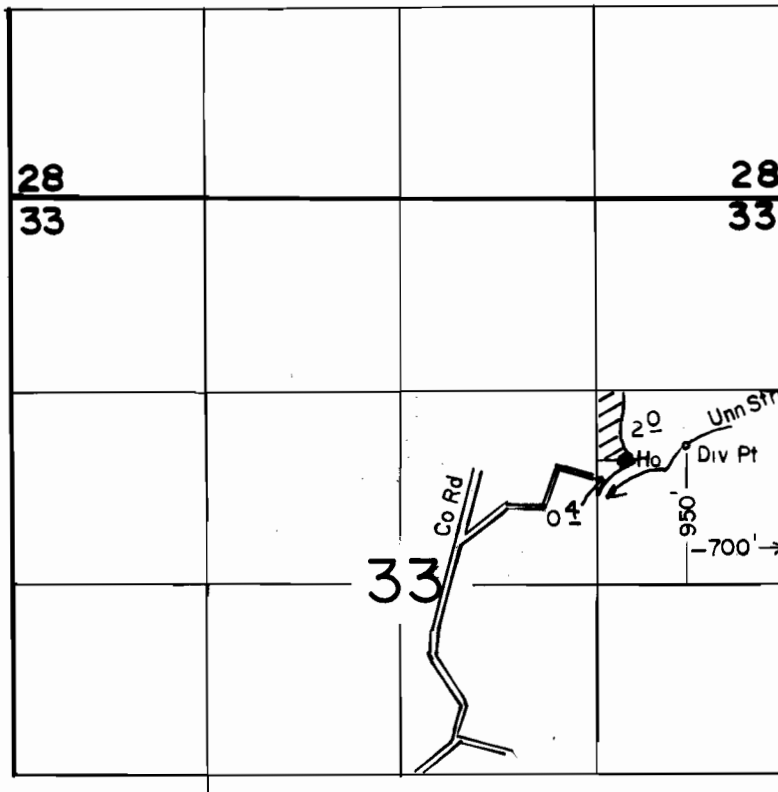

SCALE: 1"=1320

FINAL PROOF SURVEY UNDER

Application No. 63529... Permit No. 47763
IN NAME OF

AUDREY DEWESTER

Surveyed JULY 22, 1988, by B. S. JAMES