


T. 29 S., R. 6 W., W.M.

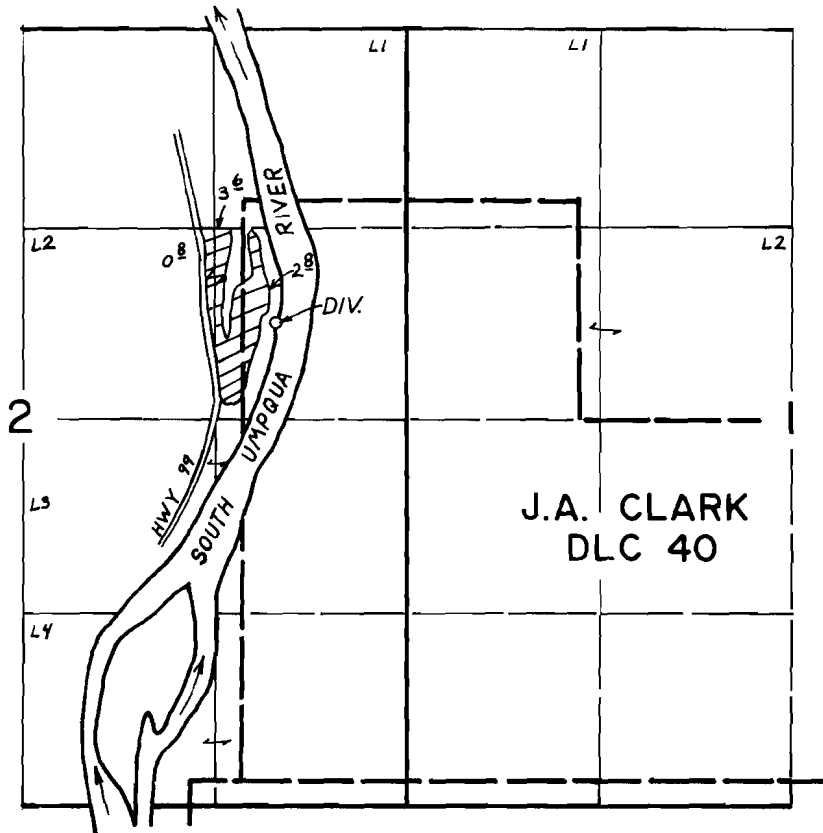

DIV. PT. LOCATED 830' S. AND 220' E. OF NW CORNER OF  
DLC 40.

SCALE: 4" = 1 mile

**FINAL PROOF SURVEY**  
UNDER

Application No. ~~63612~~ Permit No. ~~46861~~.....  
IN NAME OF

.....JERRY D. BOUNDS.....

Surveyed DEC 15 19 83, by *J.E. Cashion*.....