


T. 26 S., R. 3 W., W. M.

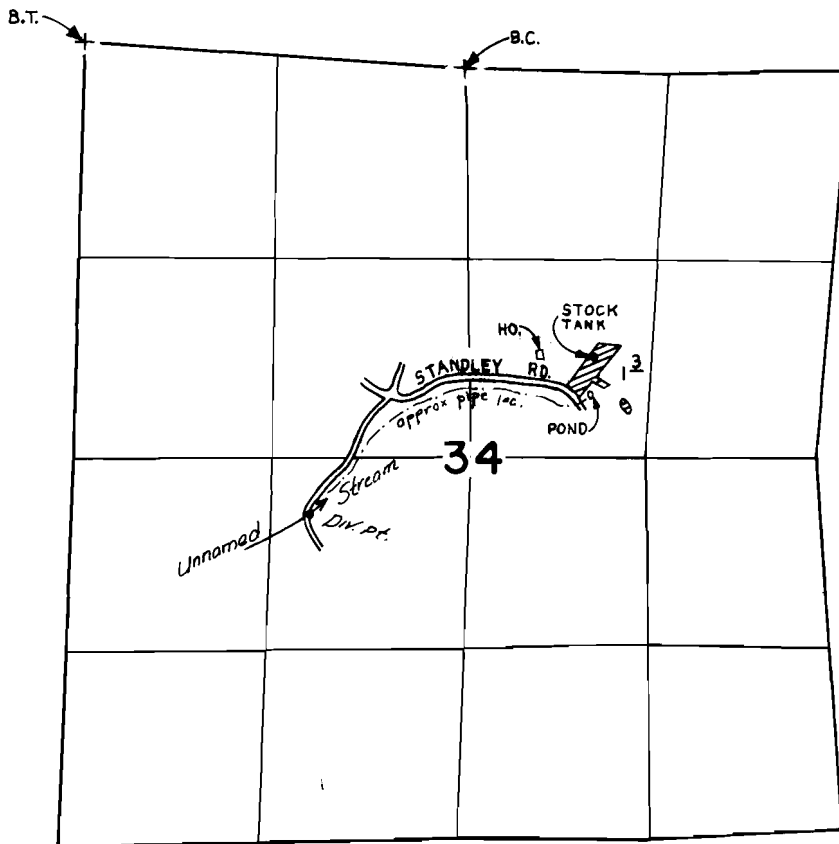

DIV. PT. LOCATED 390'S. & 1,100'W. FROM C. 1/4 COR. SEC. 34

SCALE: 4" = 1 mile

FINAL PROOF SURVEY UNDER

Application No. 63627... Permit No. 46869.....

IN NAME OF

DAN D. O'NEIL

Surveyed AUG. 2, 1984, by D. CLARK.....