


T. 2S., R. 1W., W.M.

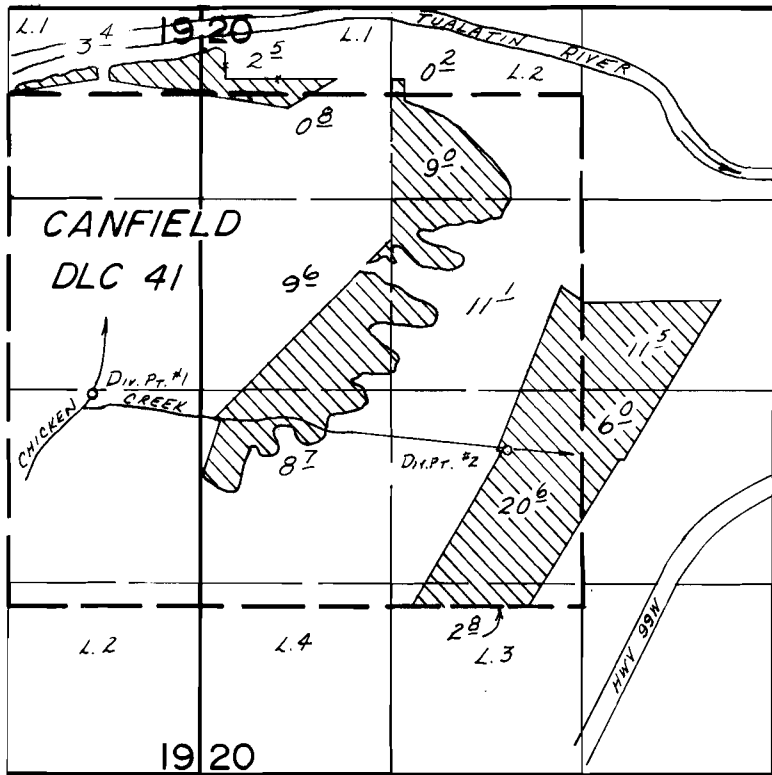

DIV. PTS LOC.: #1- 1450'N. & 570'E., #2- 1080'N. & 3450'E.,
 BOTH FROM SW COR. CANFIELD DLC 41.

SCALE: 1"=1320'

FINAL PROOF SURVEY UNDER

Application No. 63714... Permit No. 46885.....
 IN NAME OF

.....E. F. STEINBORN.....

Surveyed Sept. 26... 1984, by B.W. BISHOP.....