

Section 29
SW $\frac{1}{4}$ SE $\frac{1}{4}$
NW $\frac{1}{4}$ NE $\frac{1}{4}$
Section 32


Scale 1"=100'
Mag. Dec.=21°E.
Surveyed Aug. 1922

by
F. W. Cleston
August 1925
by
W. M. H. Woodward
Restaked and Resurveyed 1934

Application No. 63793
Permit No. 47261

5608

SCALE IN FEET

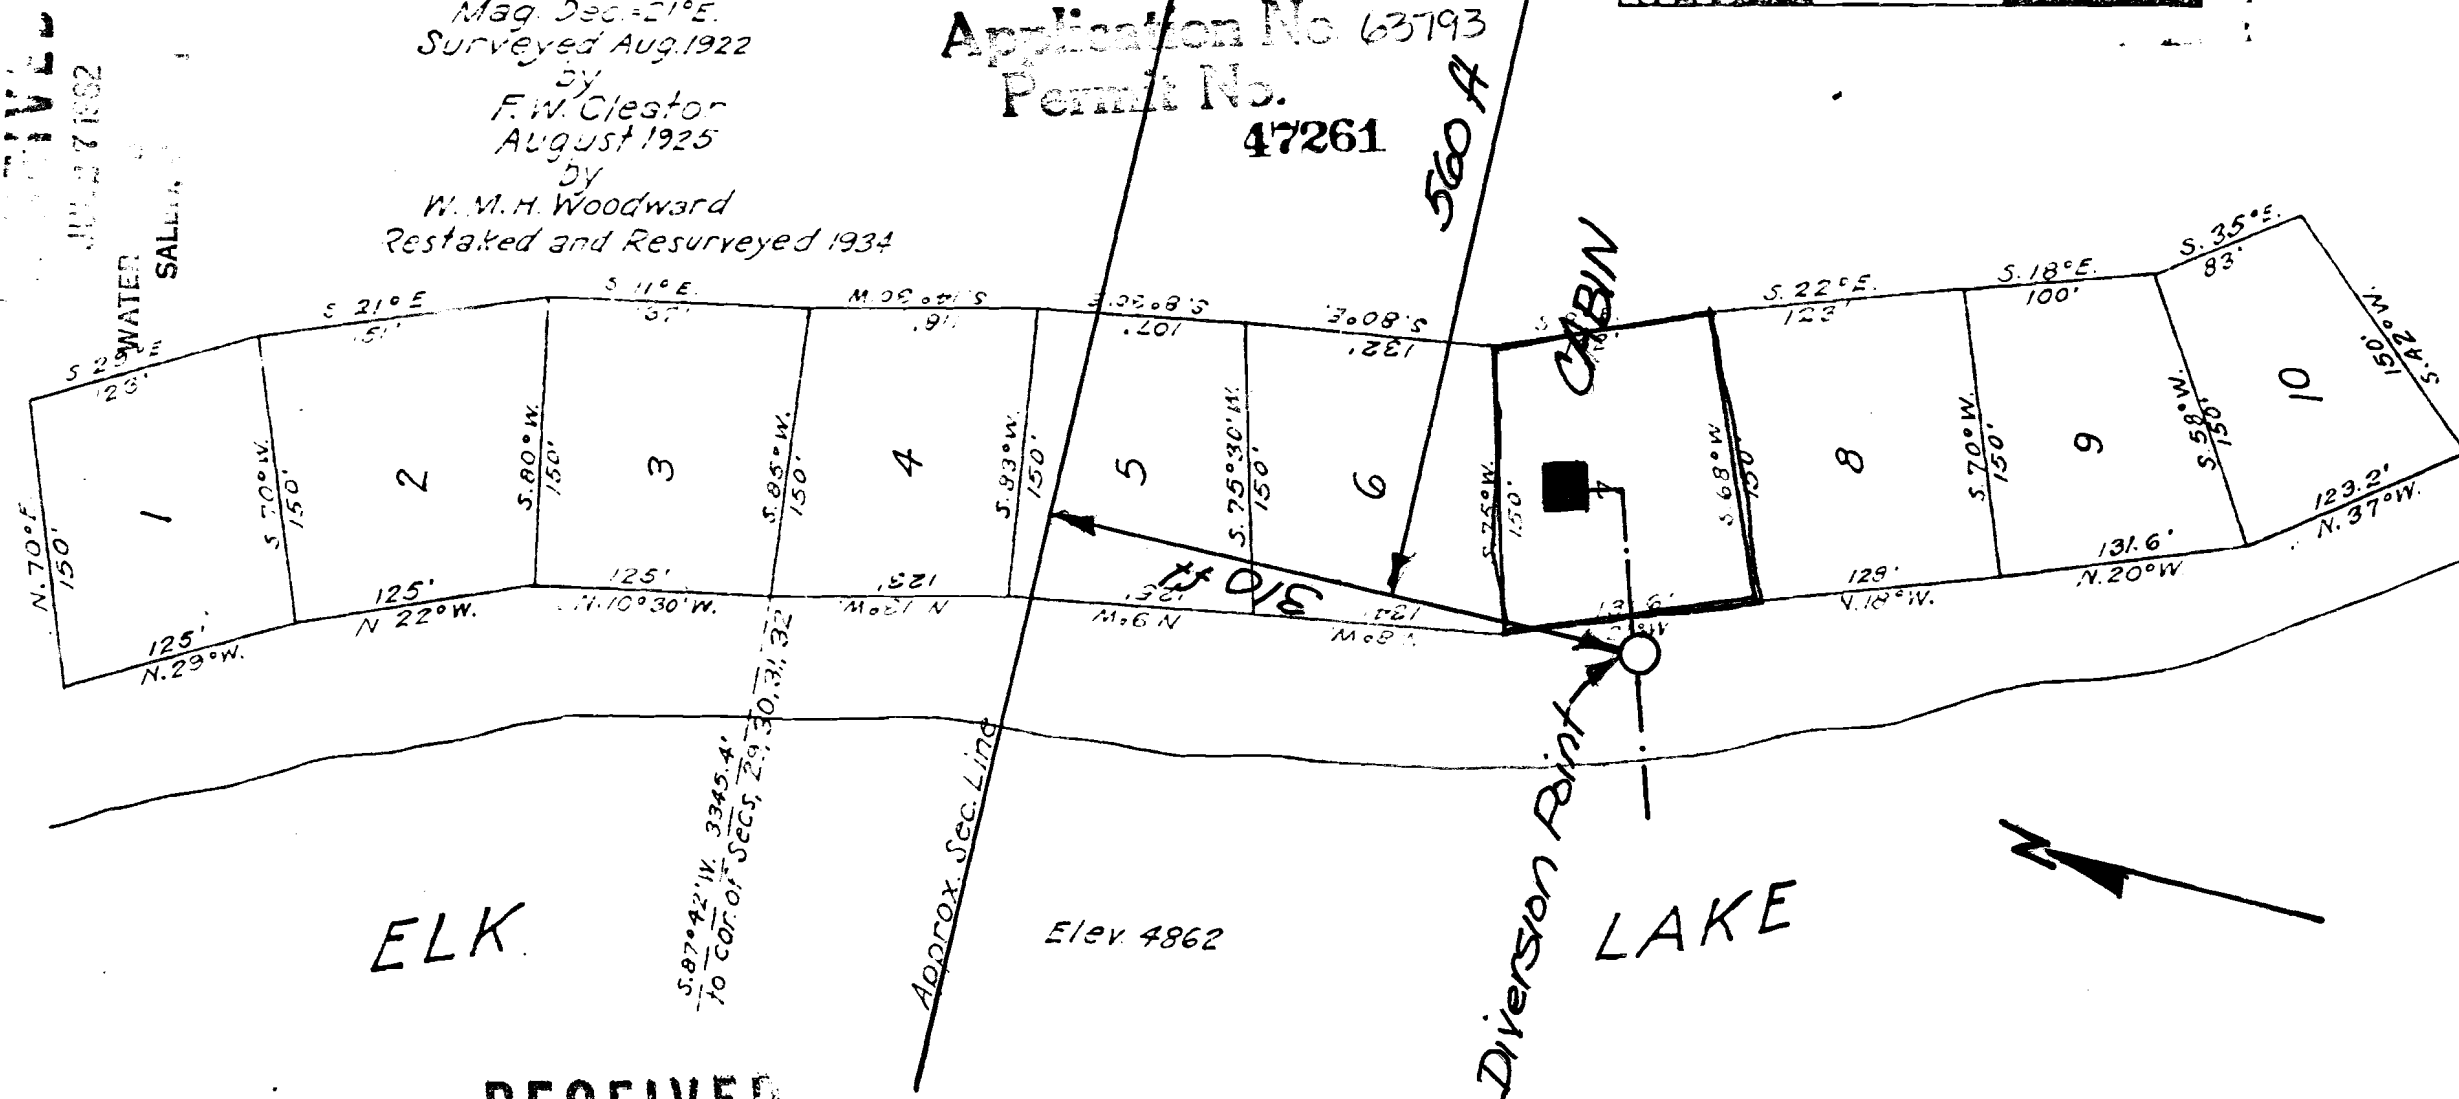

ELK.

Elev. 4862

LAKE

ACTS

RECEIVED

DEC 14 1982

**WATER RESOURCES DEPT.
SALEM, OREGON**