


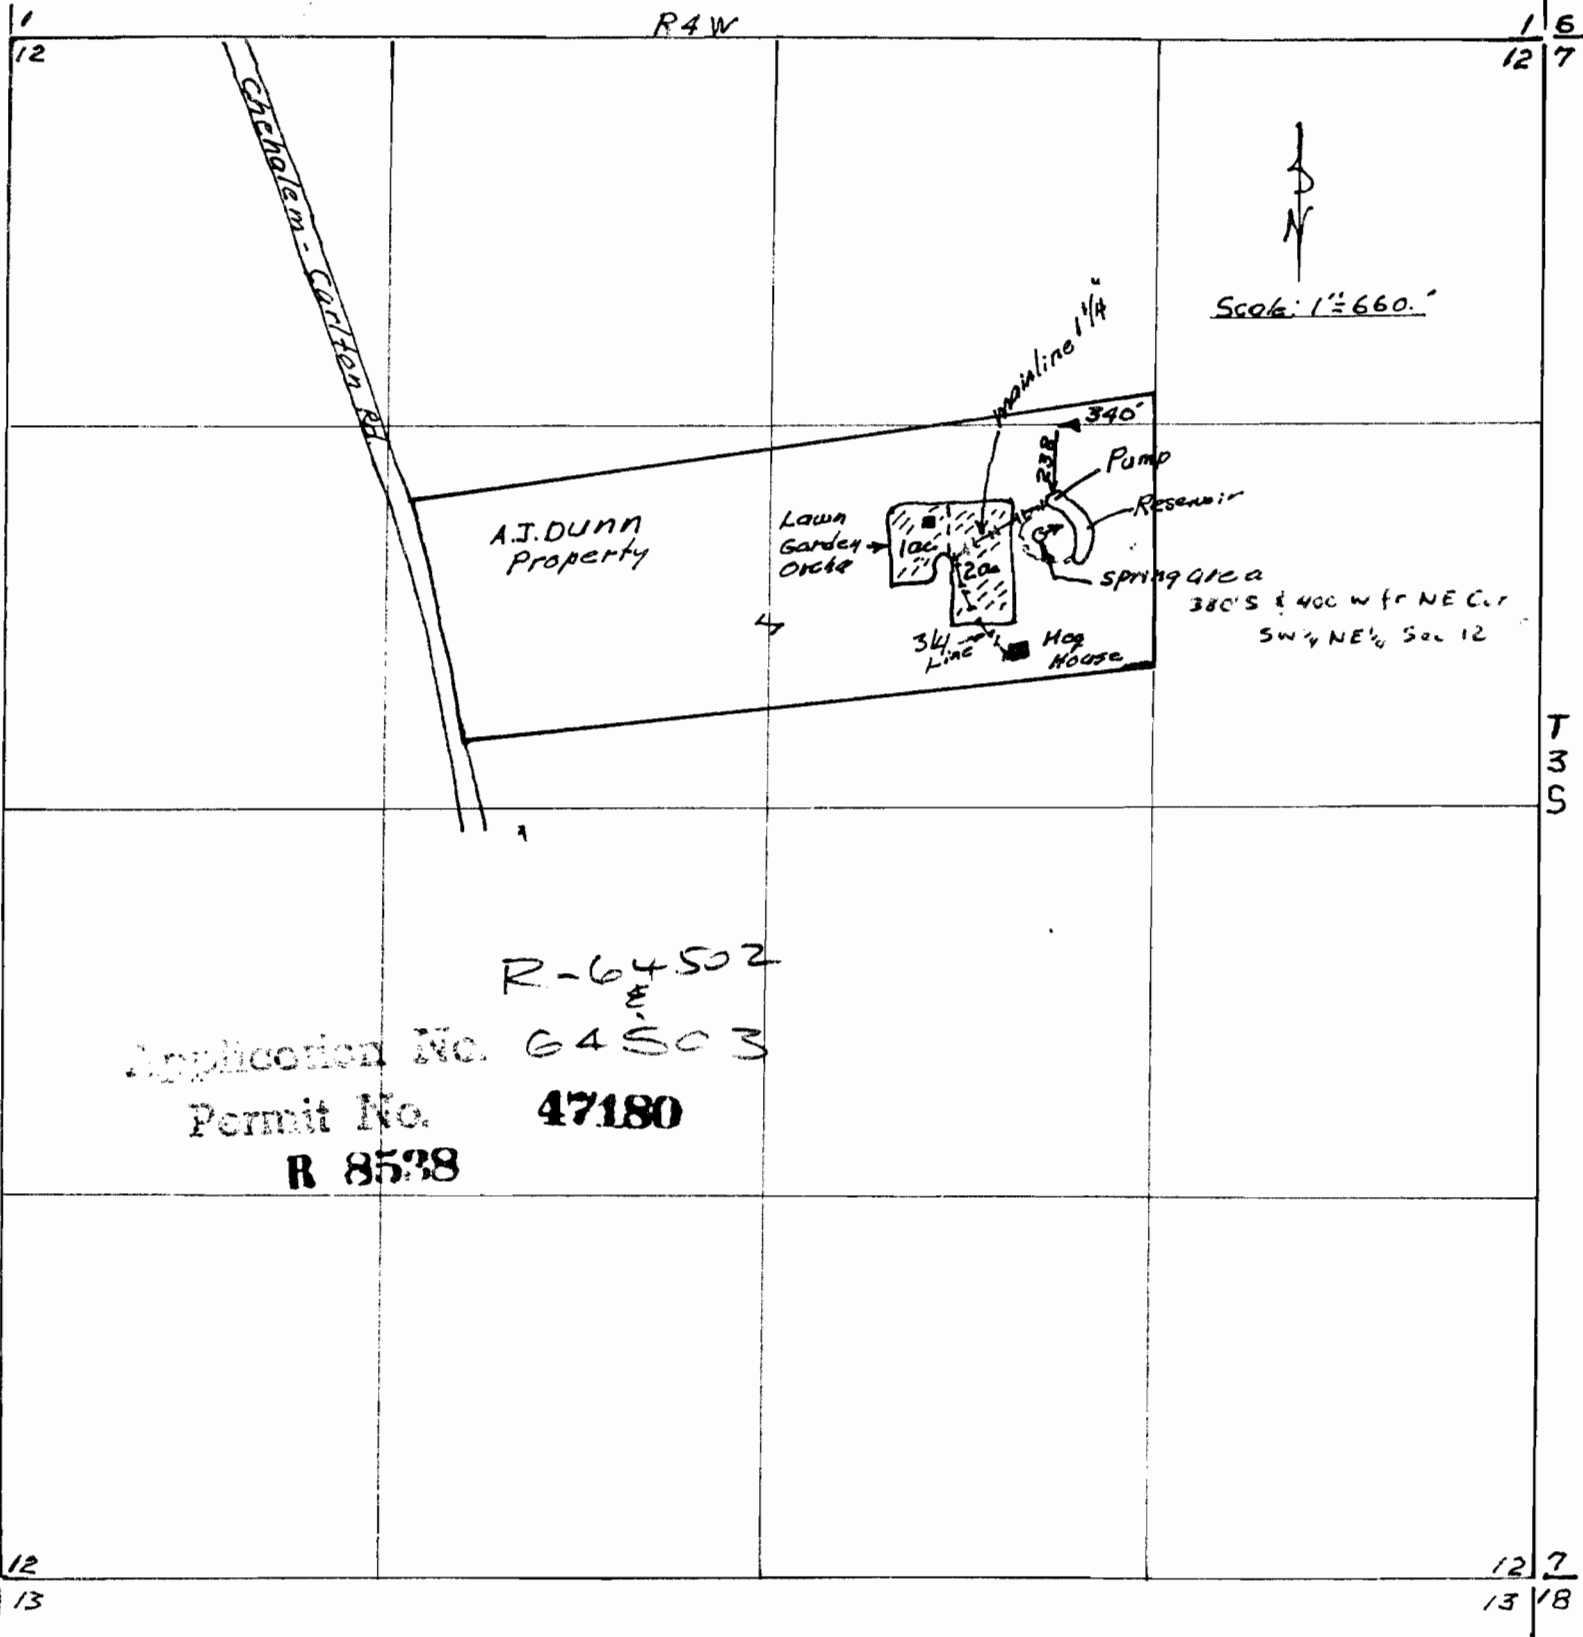

LOCATION MAP

A.J. DUNN
RT.2 BOX 50D
YAMHILL, ORE.

RECEIVED
