




T. 3 S., R. 4 W., W.M.

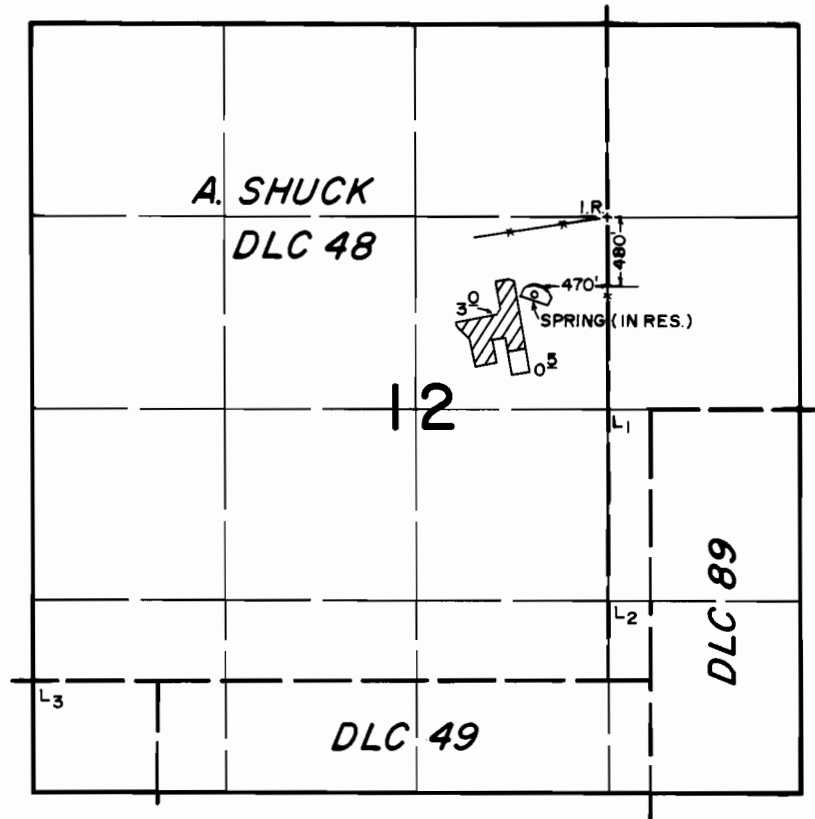

SCALE: 1" = 1320'

FINAL PROOF SURVEY
UNDER

R-64502 R-8537
Application No. 64503 Permit No. 47180
IN NAME OF

A. JOE DUNN

Surveyed APRIL 28 1989, by T. M. WARREN

10-30-89

PTS

Joe