




T. 37 S., R. 5 W., W.M.

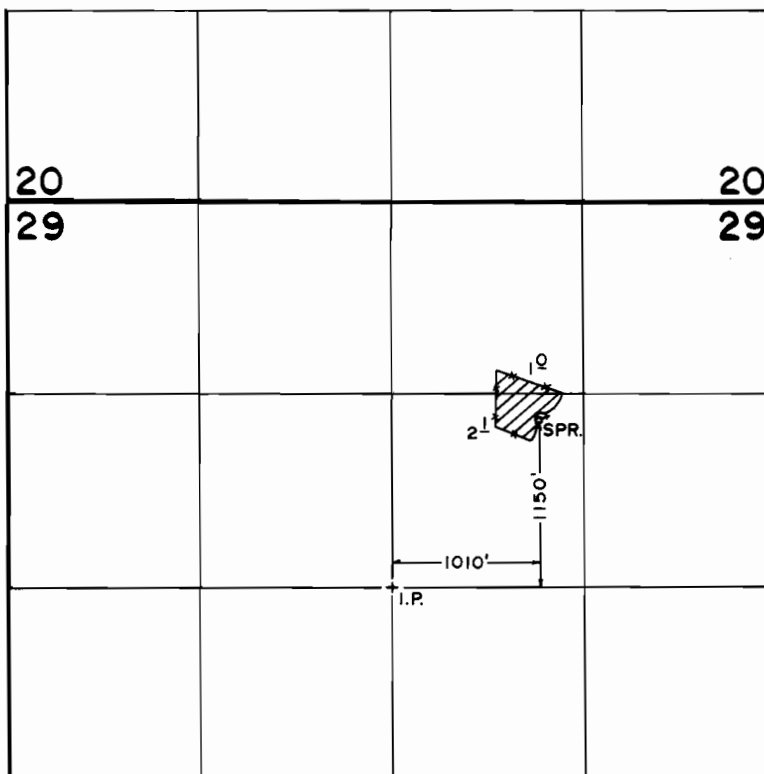

SCALE: 1" = 1320'

FINAL PROOF SURVEY
UNDER

Application No. 64521... Permit No. 47285.....
IN NAME OF

ROBERT E. & LINDA F. WILEY

Surveyed MAY 24, 1989, by B. S. JAMES.....