


T. 36 S., R. 3 W., W. M.

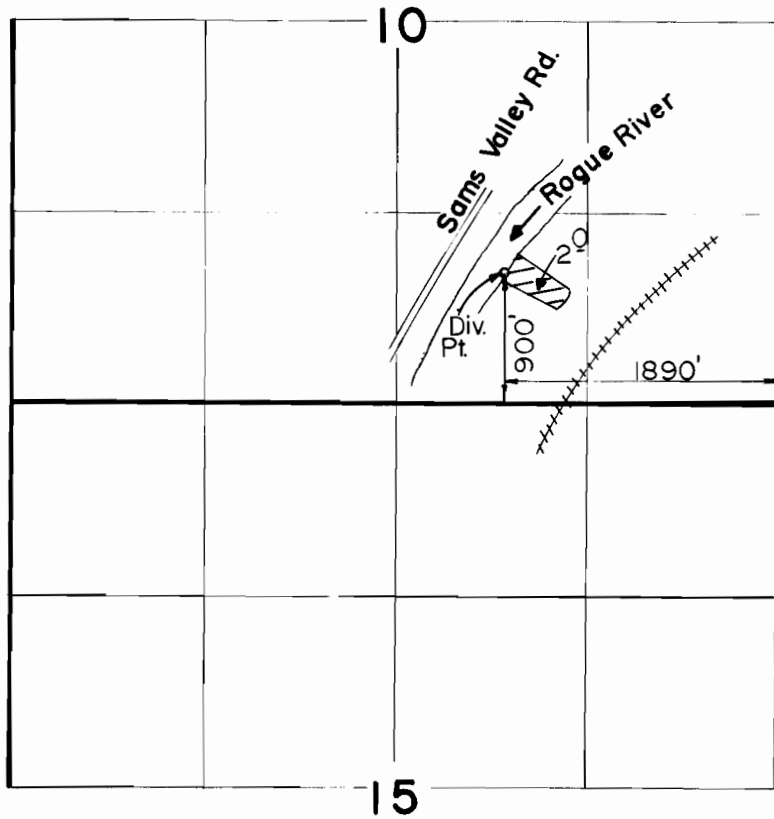

Scale: 1" = 1320'

FINAL PROOF SURVEY
UNDER

Application No. ~~64547~~ Permit No. ~~47431~~....
IN NAME OF

.....**JESSE HARRISON**.....

Surveyed MAR..II.... 1988., by B....S....JAMES...