


T. 3 S., R. 3 E., W.M.

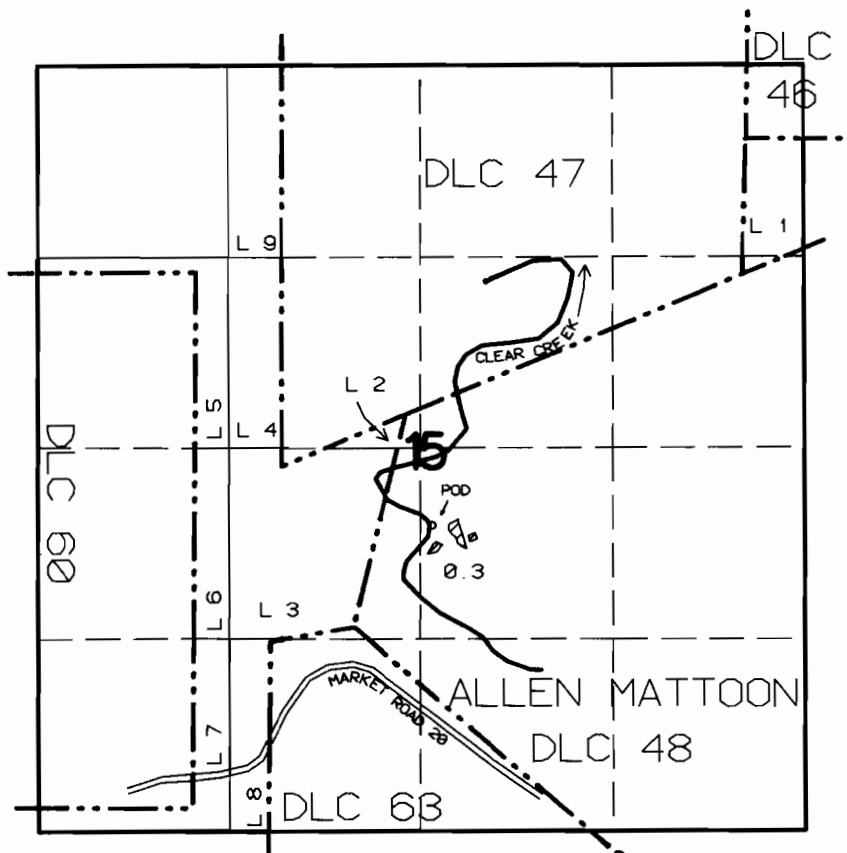

POD LOCATED: 540 FT S AND 60 FT E
FROM THE CENTER 1/4 SECTION 15

FINAL PROOF SURVEY
UNDER

Application No.: 64955 Permit No.: 47718

IN THE NAME OF

ROBERT T. & KAY C. DICKSON

Surveyed: AUG. 24, 1987

By: T. M. WARREN

RWK

41005 278 81R