
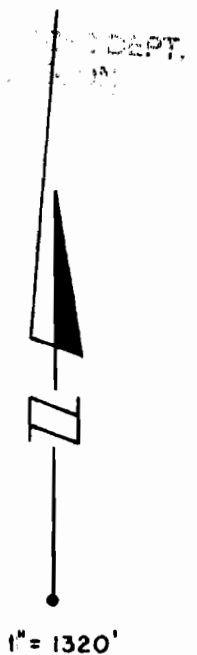


T.17S., R.3E., W.M.

SECTION II

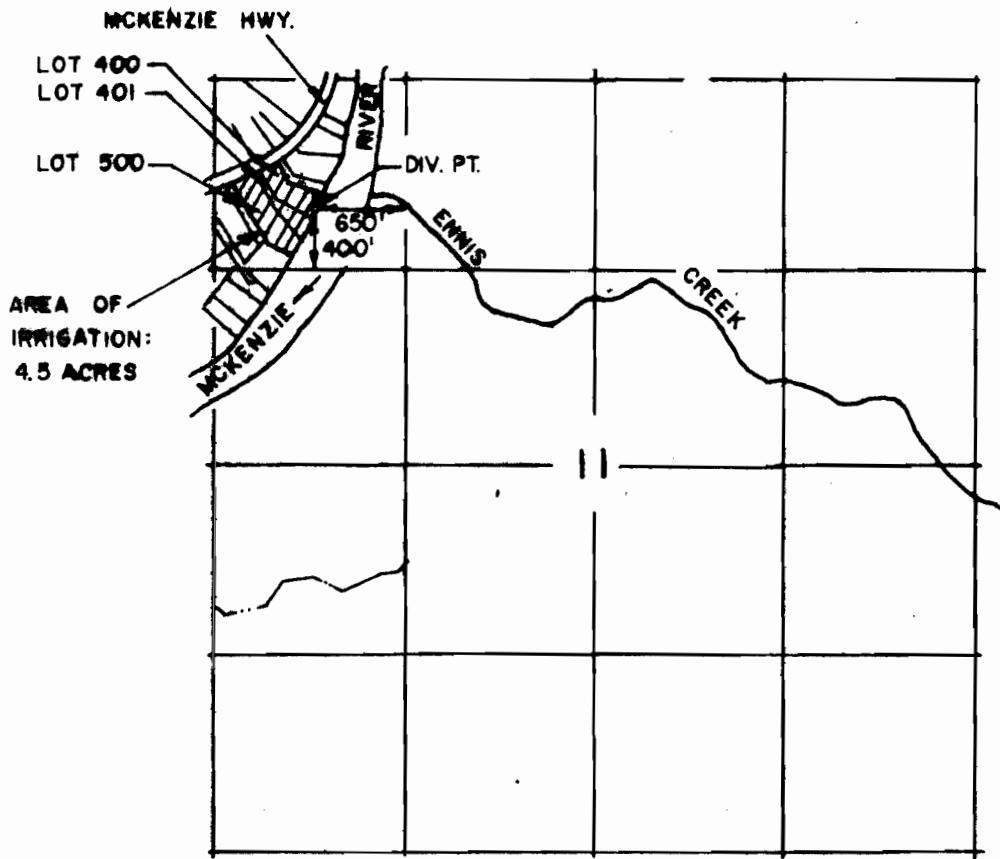

FINAL PROOF SURVEY
UNDER

APPLICATION NO. 68684 PERMIT NO. 49632

IN NAME OF
ANTHONY MEIER

SURVEYED NOV., 1984, BY T. POAGE. ENGINEERING

DRAWN BY: RGA
DATE: 8-8-88

