



NW 1/4 NE 1/4 Sec 31, T35S R14W WM
CURRY COUNTY

Scale 1"=200'

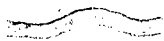


Existing gravel roads.

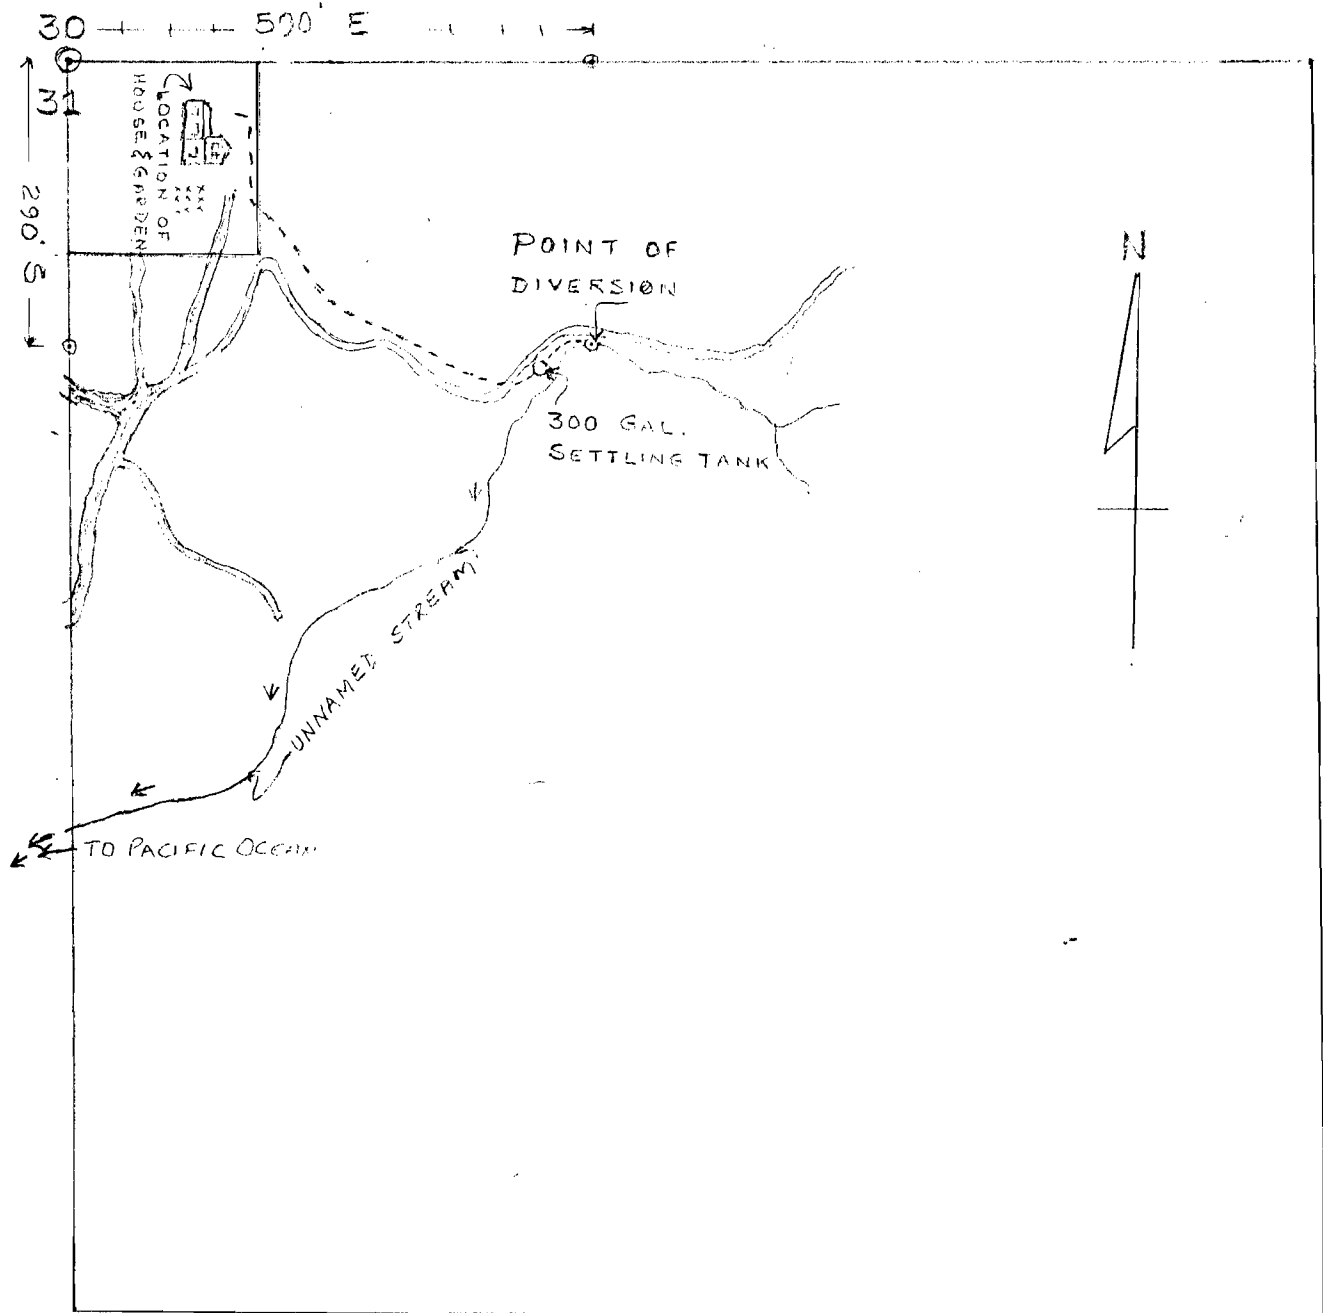

Old logging road.



Proposed PVC pipe line.

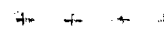

Coordinates, from N 1/4 corner.


RECEIVED

NOV 26 1986

WATER RESOURCES DEPT.
SALEM, OREGON

Application No.
Permit No.



68968
49933

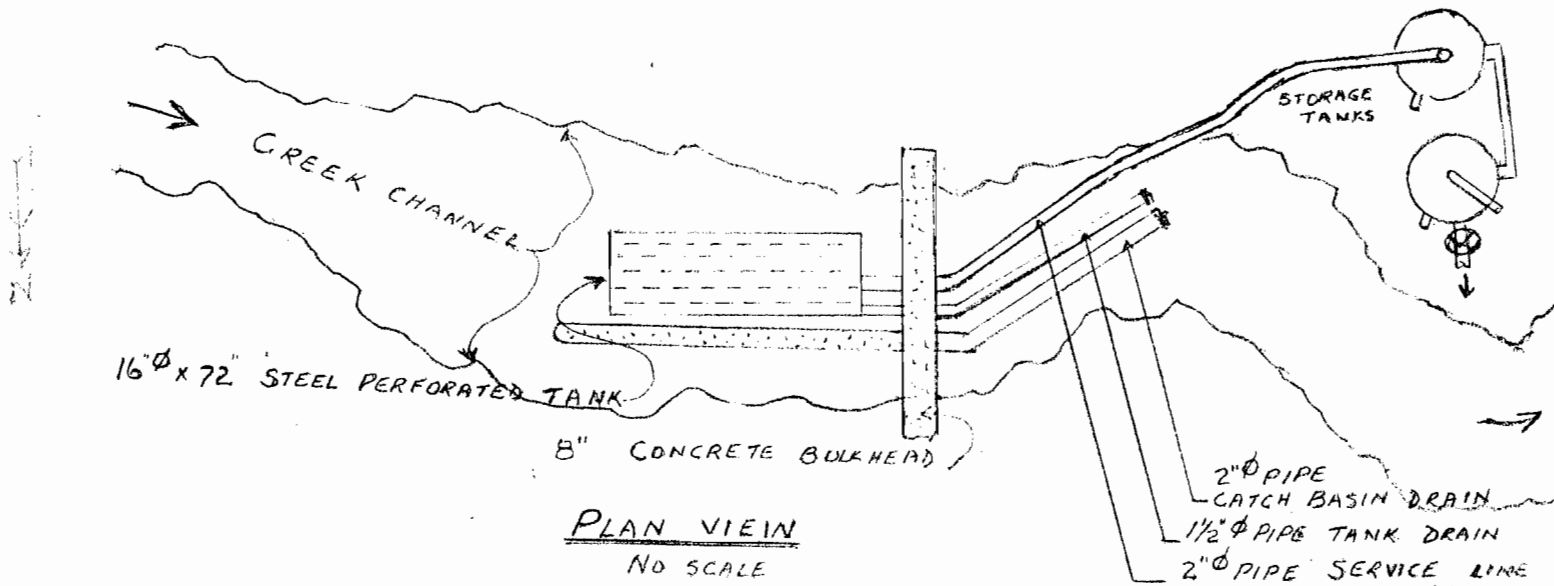

RECEIVED

NOV 26 1986

WATER RESOURCES DEPT.
SALEM, OREGON

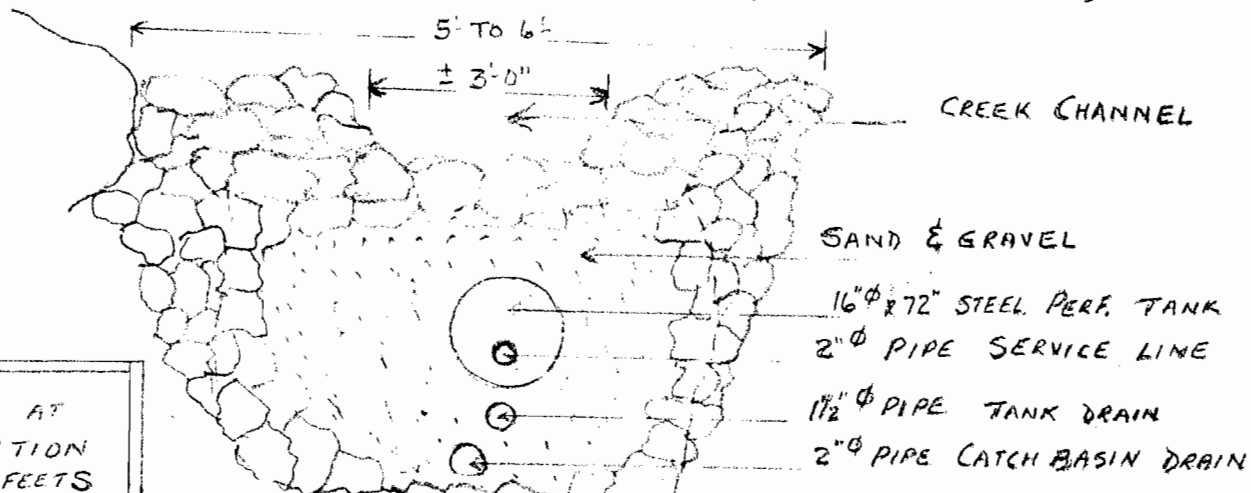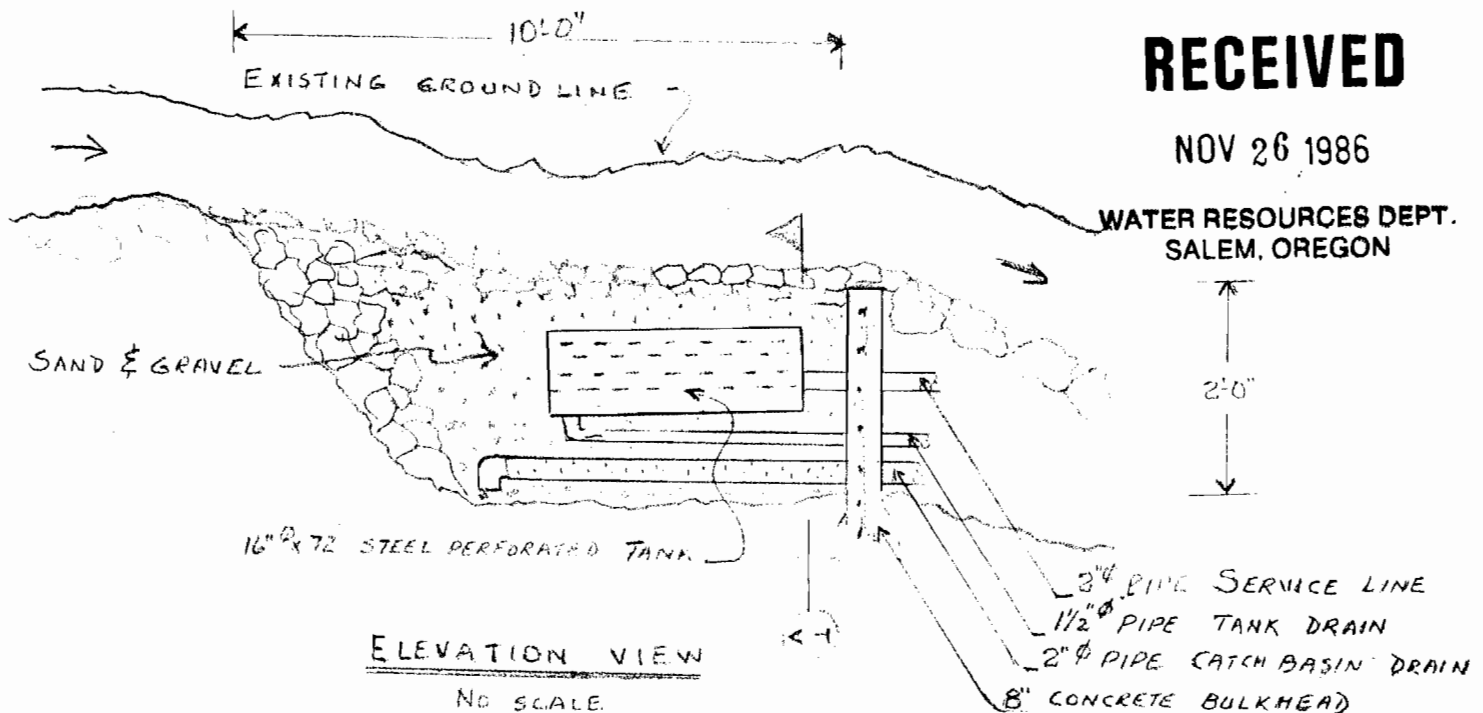

CATCH BASIN AT
POINT OF DIVERSION
LOCATED 290 FEET
& 590 FEET E OF NE 1/4
CORNER SEC. 31 T 35S
R 14 W WM.
APPLICANT: WENDELL &
MARIE AVANT

Application No. 68968
Permit No. 49933