


Section 26, T. 26 S., R. 5 W., W. M.

RECEIVED

FEB 27 1990

WATER RESOURCES DEPT  
SALEM, OREGON

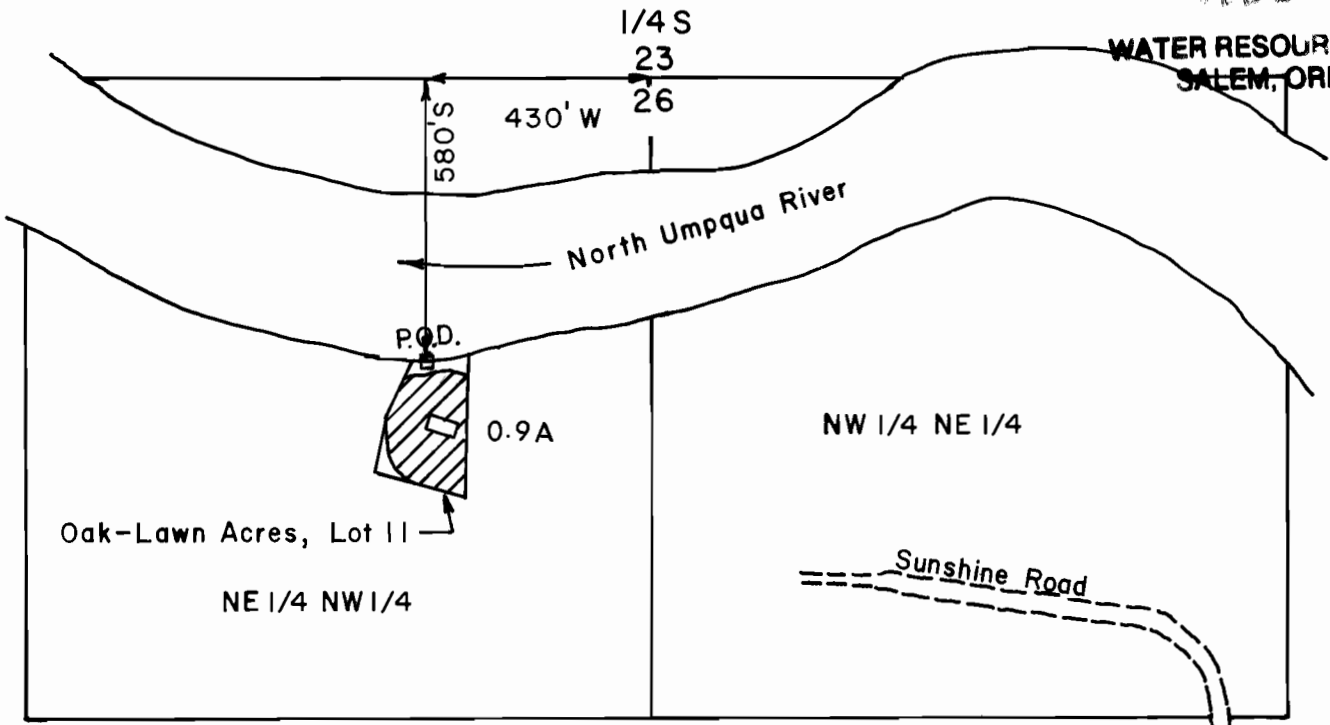


Scale: 1" = 400'


Application No. 69206

Permit No. 50118

John D. & Ruth A. Hollensteiner

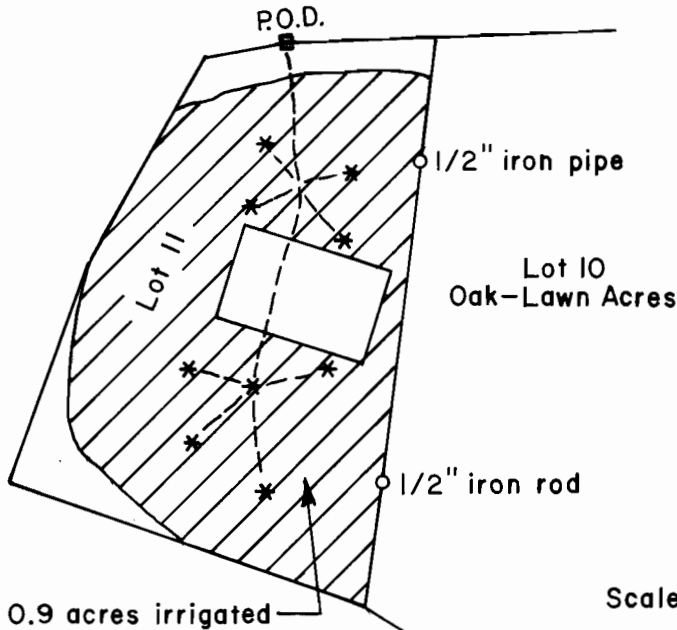

Scale: 1" = 100 ft.

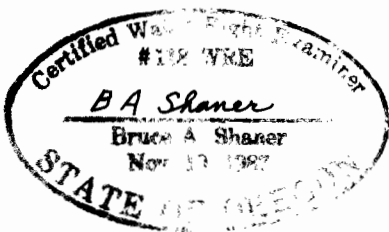

FINAL PROOF SURVEY