


T.39S., R.7W. W.M.
IN THE NE 1/4, NE
1/4 OF SECTION 23

FINAL PROOF SURVEY
UNDER

APPLICATION No. 69240
PERMIT No. 50139

IN THE NAME OF:
LEE WILLIAM PRINCE AND SANDRA PRINCE

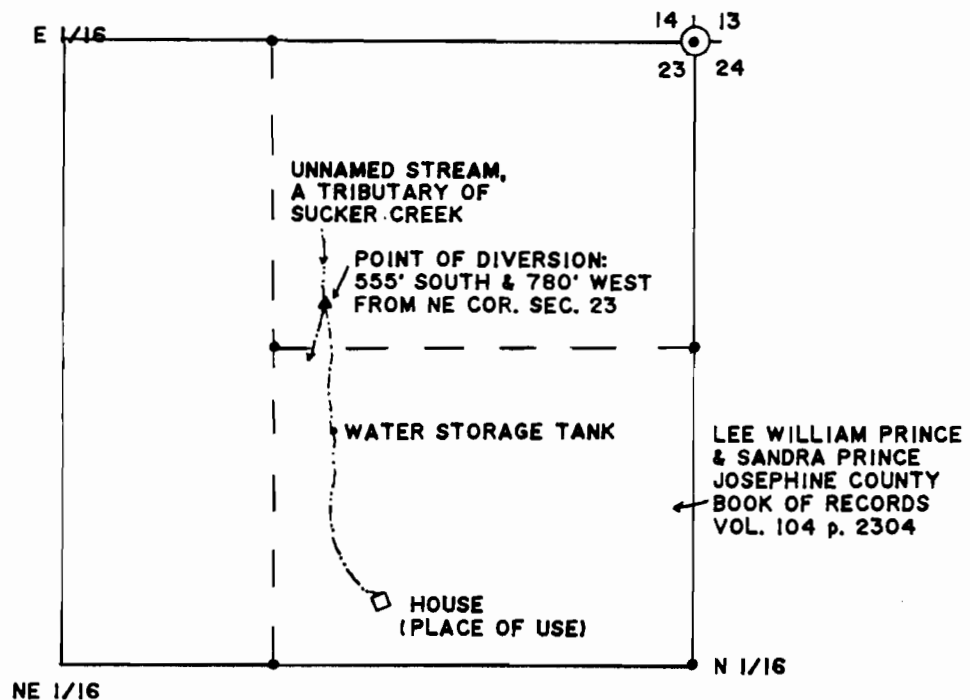

PREPARED BY:
JONATHAN C. SPERO W.R.E. 123
1002 KINCAID RD./P.O. BOX 16
WILLIAMS, OREGON 97544
PHONE (503) 846-6845

SURVEYED FEBRUARY 11, 1989

THIS MAP IS FOR THE PURPOSE OF
IDENTIFYING THE LOCATION OF THE
WATER RIGHT ONLY AND IS NOT IN-
TENDED TO PROVIDE LEGAL DIMEN-
SIONS OR LOCATIONS OF PROPERTY
OWNERSHIP LINES.

SCALE: 1" = 400'

