

Scale: 1" = 400'


5 4  
8 9

WATER  
1988  
RES DEPT.  
OREGON

Fd. 1" iron pipe set  
in C.S.F. # 21449 for the  
center of Section 8  
T22S-R3W-W.M.

The preparation of this map was for the purpose  
of identifying the location of the water right only.  
It is not intended to provide location or dimension  
of property ownership lines.

The examination was completed 3/8/88

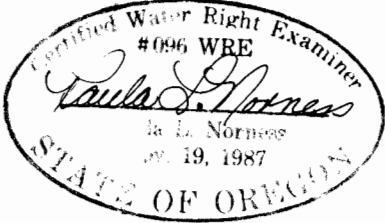

BENEFICIAL USE MAP - PERMIT 50146  
Permittee: George H. Veitch and LeAnn J. McGranahan  
74214 London Rd., Cottage Grove, Or. 97424  
942-8208

Map prepared: Paula L. Norness WRE #096  
Stephen H. Ford, Inc.  
1120 Bailey Hill Rd. #5  
Eugene, Or. 97402  
344-1852

Job #2289.7