

UMPOUA RIVER

TYEE


RD.

CO.

SUB-DIVISION


RASMUSSEN
HOLE

BENEFICIAL
USE AREA
500 GAL STORAGE
TANK *
RESIDENCE
UTILITY BLDG
WITH PRES. TANK

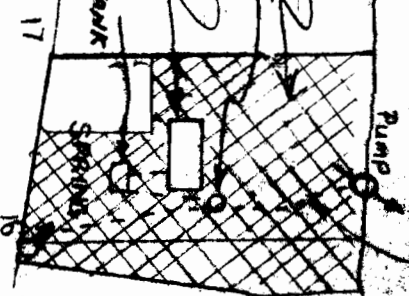

* AT STORAGE TANK - 1HP (220-V-1Ø)
SUBMERSIBLE PUMP TO PRESSURE
TANK.

- FINAL PROOF MAP -
MAP OF CLAIM OF BENEFICIAL USE.
PERMIT # 50214 - LOT 16 + PART LOT 17
RASMUSSEN HOLE SUB-DIV, DOUGLAS CO.
JOE & PAM JACKSON
6192 TYEE RD
UMPOUA, OR 97486

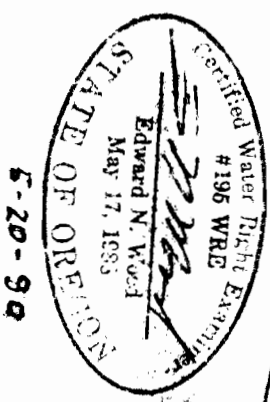

SECT. 16, T 25S, R 7. W. W. M.

CEN. SEC.

POINT OF DIVERSION, PUMP: 700' N., 1000' E

SPRING: 520' N., 1050' E
FROM CENTER SECTION CORNER

SCALE: 1" = 100'

NOT A SURVEY