

Final Proof Survey

In Sec. 34 T. 30 S., R. 12 W. W. M.


Scale: 1" = 400ft.

Nov. 15, 1989.

Application No. 69606

Permit No. 50434

In the name of Jack Warner

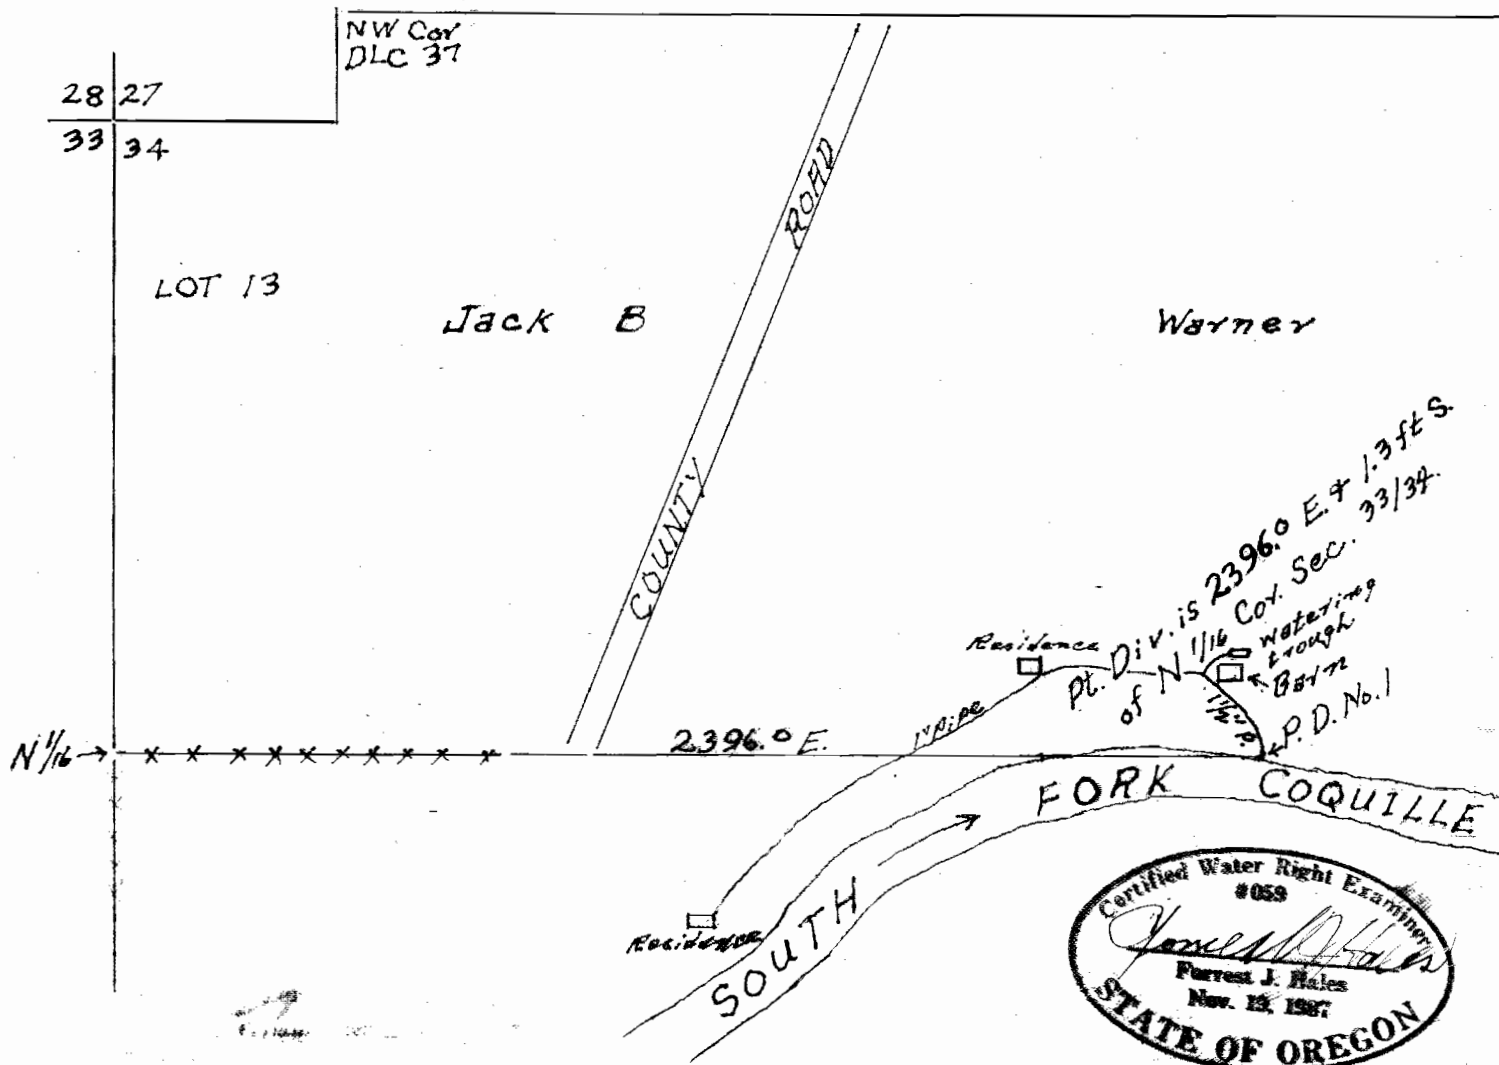


WATER RESOURCES DEPT.
 SALEM, OREGON

JUN 08 1990

RECEIVED

29 28
32 33

Final Proof Survey
In Sec. 33, T. 30 S., R. 12 W. W. M.
Scale: 1" = 400 ft Nov. 15, 1989
Application No. 69606 Permit No. 50434
In the name of Jack Warner

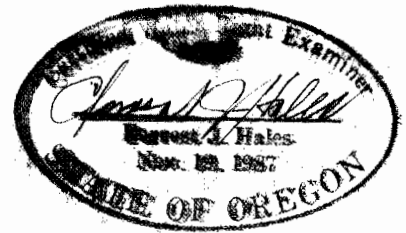

P.D. No. 2 is 64.0 ft N.
and 4.0 ft E. of 1/4 Cor. 32/33

1/4

1 1/2" pipe

watering trough

Cor.

Fd pipe post
B.C. B.T.

Jack Warner (all of Sec. 33)

RECEIVED

JAN 08 1990

WATER RESOURCES DEPT.
SALEM, OREGON