


T.29S.,R.11W.,W.M.

SCALE 1"=400'

36

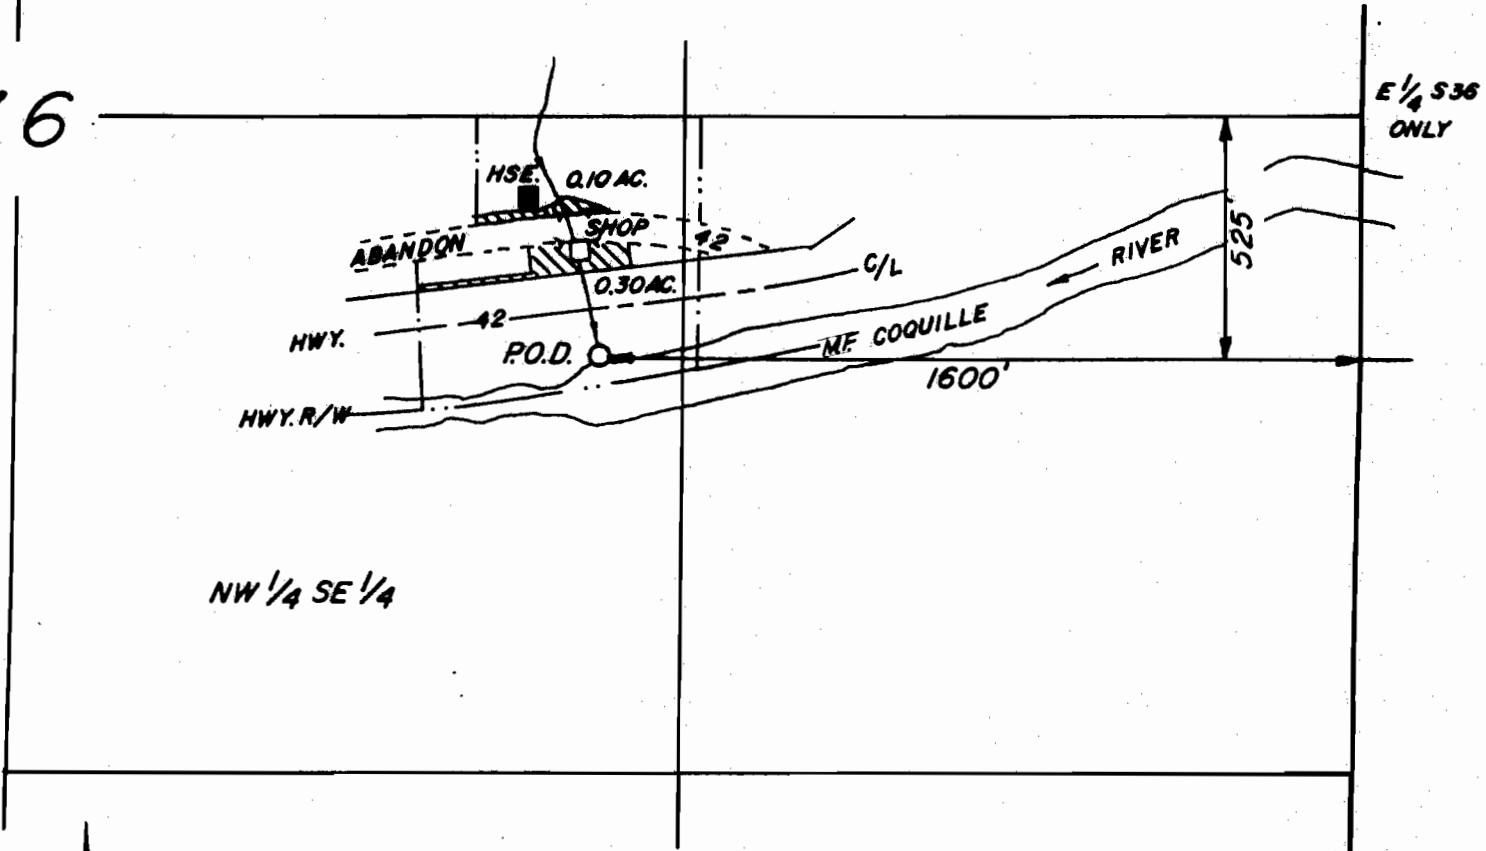

BASIS OF BEARING PER 1953 SURVEY CS2-106



FINAL PROOF SURVEY UNDER



APPLICATION NO. 69671..... PERMIT NO. 50652

IN THE NAME OF

C. EDWARD RADLOFF

SURVEYED AUG. 14, 1989..... BY RONALD E. STUNTZNER