


T29S, R6W, WM

SCALE 1" = 400'

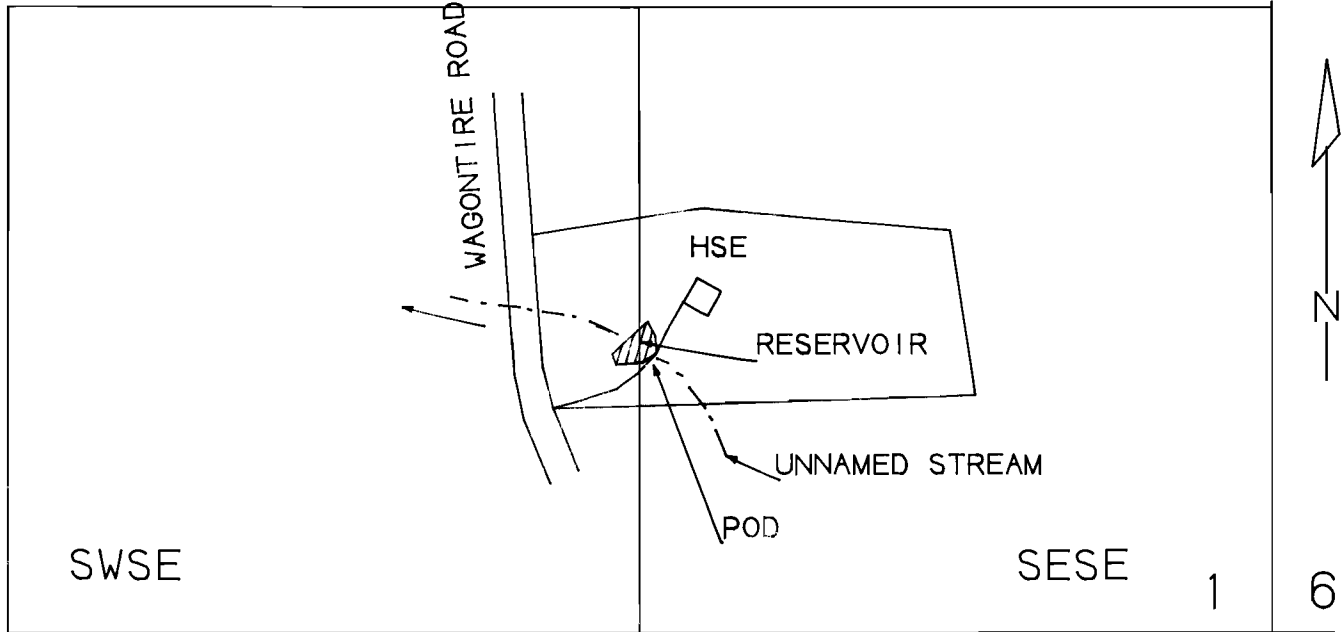

POD 590' N & 1300' W OF SE COR SEC 1

THIS IS A LOCATION MAP FOR A WATER RIGHT APPLICATION BY JOHN S. OR VIRGINIA LEE LAWLISS. THIS MAP IS FOR THE PURPOSE OF IDENTIFYING THE LOCATION OF THE WATER RIGHT ONLY AND IS NOT INTENDED TO PROVIDE LEGAL DIMENSIONS OR LOCATIONS OF PROPERTY OWNERSHIP LINES.

FINAL PROOF SURVEY

UNDER

Application No. R-69677 Permit No. R11132
IN NAME OF

JOHN S or VIRGINIA LEE LAWLISS

Surveyed Aug 1988 by

