


T. 4S., R. 28 & 3W., W.M.

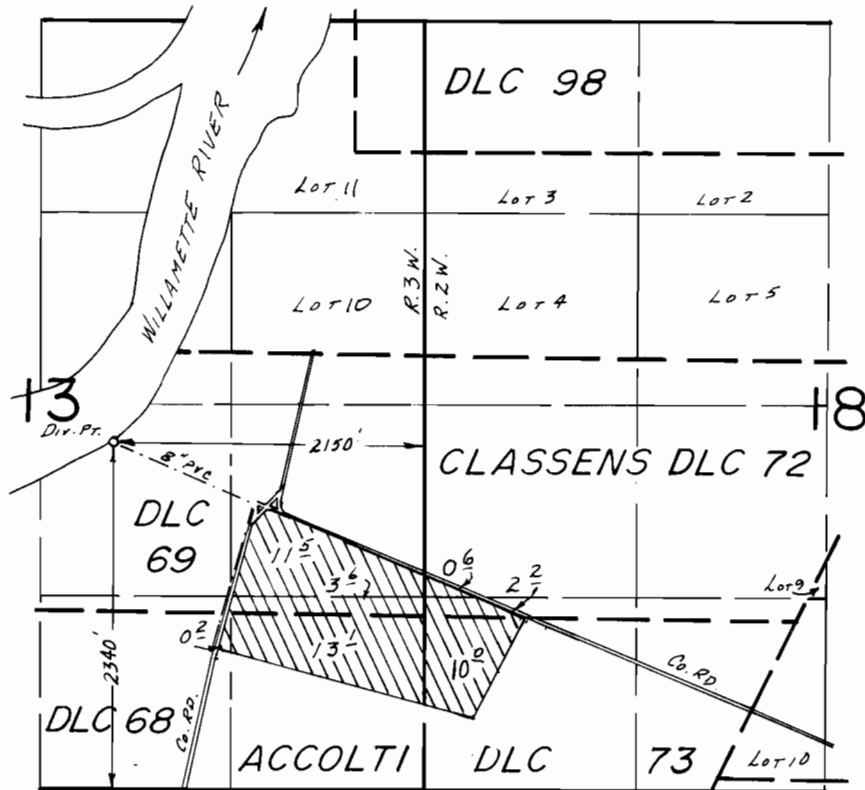

SCALE: 1" = 1320'

FINAL PROOF SURVEY
UNDER

Application No. 68139... Permit No. 48832.....

IN NAME OF

CASPER & MATILDA OTT

Surveyed Aug. 23, 1985, by B.W. BISHOP.....